

LAUDERDALE
D 57
9-67

MISSISSIPPI
BOARD OF WATER COMMISSIONERS
416 North State Street
Jackson, Mississippi 39201

WATER WELL DRILLERS LOG

9-18-1967 date well completed
Lenny Dilling firm name
Laud county well located


LANDOWNER:
Ready-Mix Concrete
16-26 Ave S. mbr.
(mailing address)

description of formations encountered	from to	
	ft	ft
yellow sand & clay	0	95
blue clay	95	150
good sand	150	191

WELL LOCATION:
sec 28 T 8 N R 17 E
3 miles W-SW of Lauderdale
(distance) (direction) (nearest town)

WELL PURPOSE:
(home, irrigation, municipal, industrial)

- WELL COMPLETION DATA:
- (1) diameter (inches) 4"
 - (2) total depth (feet) 191
 - (3) static water level (feet) 25 (below) above top of ground.
 - (4) casing (material) (depth) 150'
2 1/2" (size) (telescope see back.)
 - (5) screen (length) (depth to top) 20' 171'
2 1/2" (size) (material) Stainless Steel
 - (6) pump (HP) (yield gpm) 3 75
Submersible (type power)
 - (7) electric log (yes or no) No
(organization running log)
 - (8) how well bottom plugged Wash
Value

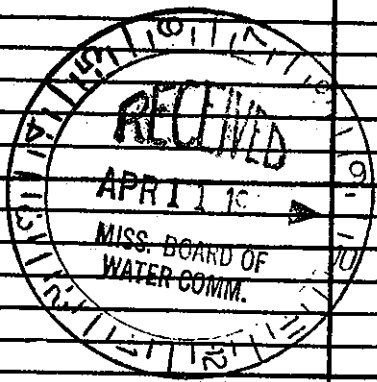

DRILLERS REMARKS:
Good sand in bottom of well.