

LAUDERDALE
D 59
11-67

MISSISSIPPI
BOARD OF WATER COMMISSIONERS
416 North State Street
Jackson, Mississippi 39201

WATER WELL DRILLERS LOG

11-22-1967 date well completed
Jerry Drilling Co. firm name
Lauder county well located


LANDOWNER:
Dr. Merton Miller
Lauderdale, Miss.
(mailing address)

description of formations encountered	from	to
	yellow sand & clay	0
blue clay	65	120
sandy	120	158

WELL LOCATION:
sec 27 T 8 N R 17 E
2 miles SW of Lauderdale
(distance) (direction) (nearest town)

WELL PURPOSE: Home
(home, irrigation, municipal, industrial)

- WELL COMPLETION DATA:
- (1) diameter (inches) 4
 - (2) total depth (feet) 158'
 - (3) static water level (feet) 70' ^{Below} _{above} top of ground.
 - (4) casing galv. 128' (material) (depth)
2" (size) If telescope see back.
 - (5) screen 10' 148' (length) (depth to top)
2" Stainless steel (size) (material)
 - (6) pump 1/2 7 (HP) (yield gpm)
Submersible (type power)
 - (7) electric log No (yes or no)
(organization running log)
 - (8) how well bottom plugged wash

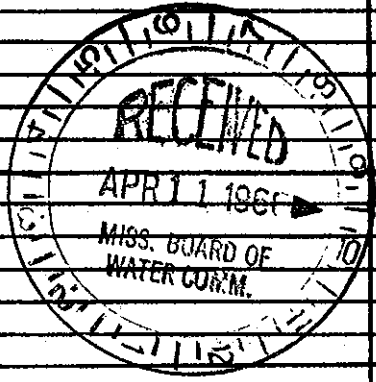

DRILLERS REMARKS: