

MISSISSIPPI BOARD OF WATER COMMISSIONERS

WATER WELL DRILLERS LOG

CODED

LAUD.
D 73
12-28-61

Date: 12-28, 1961, Driller: McDONALD HILL County: LAUDERDALE
(Name)

(1) Owner of Land: John JOHNSON
(Name)
R# 4 MERIDIAN S 1/4
(Address)
(2) Location: 1/4, 30 Sec. T. R.
15 miles EAST, of MERIDIAN
(distance) (direction) (Nearest Town)
(3) Topography: X
(Hilly) (Flat) (Level)
(4) Purpose of Well: DOMESTIC
(Domestic Irrigation
Municipal, Industrial, Other)


Description & Color of Materials Sand, Clay, Red Clay, Shell, etc.	Thick- ness Feet	Depth Feet
<u>CLAY</u>	<u>0</u>	<u>18</u>
<u>SHALE</u>	<u>18</u>	<u>140</u>
<u>SAND</u>	<u>140</u>	<u>155</u>

Information upon completion of well:

(1) Diameter 3" inches.
(2) Total Depth 155' feet.
(3) Water Level 39' feet below top of ground.
(4) Cased to 147', Size 3"
(5) Screen: Size 2", Length 6'
(6) Were any formations sealed against pollution?
_____ yes, _____ no.

If YES depth of formation _____
Why _____
Drillers Remarks: _____

CODED

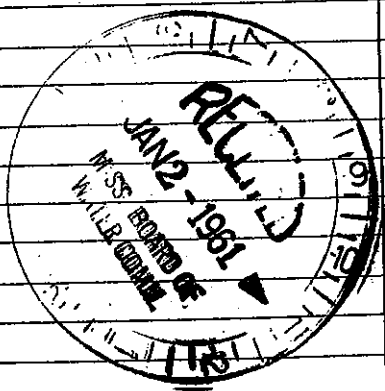

Well No.

(Use Back Side)

Mail this copy to Board of Water Commissioners 429 Miss. St. Jackson, Miss.