

MISSISSIPPI BOARD OF WATER COMMISSIONERS

LAUD.

D74

WATER WELL DRILLERS LOG

CODED

5-1-62

Date: 5-1, 1962, Driller: M. Donald & H. N. [unclear] County Lauderdale

(Name)

(1) Owner of Land: Mann's Molland
(Name)

Rt #2, Lauderdale, Miss.
(Address)

(2) Location: 1/4, 1/4, Sec 16 S & W 7
12 miles North of Meridian
(distance) (direction) (Nearest Town)

(3) Topography: (Hilly) (Flat) (Level)

(4) Purpose of Well: Domestic
(Domestic Irrigation, Municipal, Industrial, Other)

Description & Color of Materials Sand, Clay, Red Clay, Shell, etc.	Thick- ness Feet	Depth Feet
<u>Clay</u>	<u>0</u>	<u>10</u>
<u>Sandy Shale</u>	<u>10</u>	<u>22</u>
<u>Sand</u>	<u>22</u>	<u>30</u>
<u>Shale & lignite</u>	<u>30</u>	<u>100</u>
<u>Sand</u>	<u>110</u>	<u>170</u>

Information upon completion of well:

(1) Diameter 2 inches.

(2) Total Depth 170 feet.

(3) Water Level 8' feet below top of ground.

(4) Cased to 165', Size 2"

(5) Screen: Size 2", Length 5'


(6) Were any formations sealed against pollution?
 _____ yes, no.

CODED

If YES depth of formation _____

Why _____

Drillers Remarks: _____

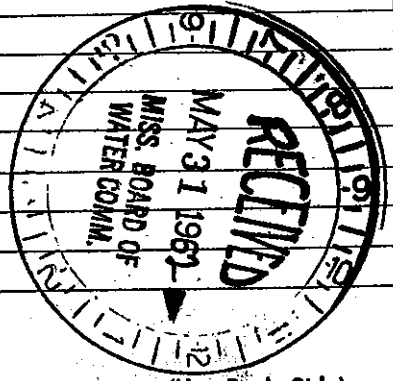

Well No. _____

Mail this copy to Board of Water Commissioners 429 Miss. St. Jackson, Miss.