

LAUD.

MISSISSIPPI BOARD OF WATER COMMISSIONERS

D 75
7-17-62

WATER WELL DRILLERS LOG

CODED


Date: 7-17, 1962, Driller: M. E. Donald Hill County Lauderdale
(Name)

		Description & Color of Materials Sand, Clay, Red Clay, Shell, etc.	Thick- ness Feet	Depth Feet
(1) Owner of Land: <u>John A. Johnson Sr.</u> (Name)		<u>Clay shale</u>	<u>0</u>	<u>30</u>
<u>Lauderdale, Miss.</u> (Address)		<u>Shale</u>	<u>30</u>	<u>60</u>
(2) Location: <u>1/4</u> , <u>1/4</u> Sec. <u>8</u>		<u>Fine Sand</u>	<u>60</u>	<u>95</u>
<u>15</u> miles <u>north</u> , of <u>Meridian</u> (distance) (direction) (Nearest Town)		<u>C. Sand</u>	<u>95</u>	<u>105</u>
(3) Topography: <input checked="" type="checkbox"/> (Hilly) <input type="checkbox"/> (Flat) <input type="checkbox"/> (Level)		<u>Shale</u>	<u>105</u>	<u>120</u>
(4) Purpose of Well: <u>Domestic</u> (Domestic Irrigation Municipal, Industrial, Other)		<u>Coarse Sand</u>	<u>120</u>	<u>160</u>

Information upon completion of well:

- (1) Diameter 4" inches.
- (2) Total Depth 160 feet.
- (3) Water Level 30 feet below top of ground.
- (4) Cased to 105, Size 4"
160, Size 2"
- (5) Screen: Size 2, Length 5'
- (6) Were any formations sealed against pollution?
no, yes.

CODED

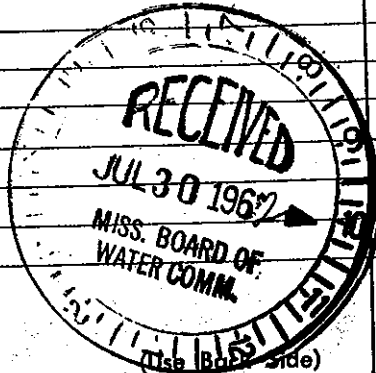

Well No.

Mail this copy to Board of Water Commissioners 429 Miss. St. Jackson, Miss