

MISSISSIPPI BOARD OF WATER COMMISSIONERS

LAUD.
D 77
8-628

WATER WELL DRILLERS LOG

CODED

McDONALD & HILL, Inc.

Date: 1962, Driller: P. O. Box 81 County Land

Meridian, MISSISSIPPI

(1) Owner of Land: H. D. Null
(Name)
Russell, Miss.
(Address)

(2) Location: $\frac{1}{4}$, 26 & 17 Sec. 8 T. 17 R. 8
8 miles NE of McC. Dr.
(distance) (direction) (Nearest Town)

(3) Topography: (Hilly) (Flat) (Level)

(4) Purpose of Well: Domestic
(Domestic Irrigation, Municipal, Industrial, Other)

Description & Color of Materials Sand, Clay, Red Clay, Shell, etc.	Thick- ness Feet	Depth Feet
Clay	0	15
Shale	15	40
Shale	40	90
Sand shale	90	96
H. Shale	96	170
M Shale	170	185
Rock	185	190
Soft Shale	190	207
Sandy Shale	207	222
fine sand	222	262
Shale-sand	262	270

Information upon completion of well:

(1) Diameter 3 inches.


(2) Total Depth 270 feet.

(3) Water Level 150 feet below top of ground.

(4) Cased to 168, Size 3

(5) Screen: Size _____, Length _____

(6) Were any formations sealed against pollution?
 yes, no.

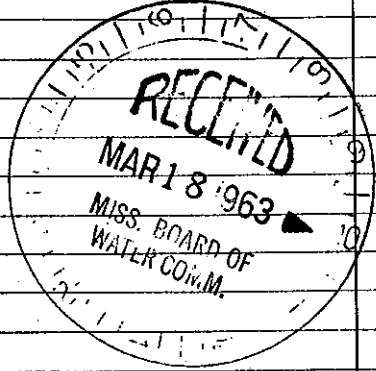

CODED

If YES depth of formation _____

Why _____

Drillers Remarks: _____

Well No.

(Use Back Side)

Retain this copy for your office files.