

LAUD. MISSISSIPPI BOARD OF WATER COMMISSIONERS

D79
5-27-63

WATER WELL DRILLERS LOG

CODED

Date: 8-27, 1963, Driller: Holly Overstreet County Laud
(Name)

(1) Owner of Land: Mr. Rawson
(Name)
Lauderdale, Miss.
(Address)
35 8th St
(2) Location: 1/4, 1/4, Sec. 8
16 miles N of MDN
(distance) (direction) (Nearest Town)
(3) Topography: _____
(Hilly) (Flat) (Level)
(4) Purpose of Well: Domestic
(Domestic Irrigation
Municipal, Industrial, Other)


Description & Color of Materials Sand, Clay, Red Clay, Shell, etc.	Thick- ness Feet	Depth Feet
<u>yellow sand</u>	<u>0</u>	<u>50</u>
<u>Shale + sand</u>	<u>50</u>	<u>100</u>
<u>Sandy</u>	<u>100</u>	<u>116'</u>

Information upon completion of well:

(1) Diameter 2 inches.
(2) Total Depth 116' feet.
(3) Water Level 30' feet below top of ground.
(4) Cased to 116, Size 2"
(5) Screen: Size 2", Length 6'
(6) Were any formations sealed against pollution?
_____ yes, no.

If YES depth of formation _____
Why _____
Drillers Remarks: _____

CODED

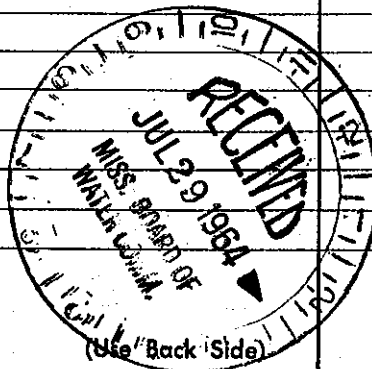

Well No.

Retain this copy for your office files.