

LANDERDALE  
D 106  
5-21-74

MISSISSIPPI **CODED**  
BOARD OF WATER COMMISSIONERS  
416 North State Street  
Jackson, Mississippi 39201

WATER WELL DRILLERS LOG

5.21.74 19 MCDONALD + HILL LAUDERDALE  
date well completed firm name county well located

LANDOWNER:  
BARRY BOES  
DALEWOOD LAKE  
(mailing address)

WELL LOCATION:  
sec. 85 T 8 N R 17 E  
EAST SIDE DALEWOOD LAKE  
(distance) miles (direction) of (nearest town)


WELL PURPOSE: HOME  
(home, irrigation, municipal, industrial)

WELL COMPLETION DATA:

- (1) diameter (inches) 4 1/2
- (2) total depth (feet) 148'
- (3) static water level (feet) 20' below top of ground.
- (4) casing PVC, 110'  
(material) (depth)  
4 1/2" if telescope see back.  
(size)
- (5) screen 6', 142'  
(length) (depth to top)  
2", PVC  
(size) (material)
- (6) pump 1/2 SUB, 10  
(HP) (yield gpm)  
E  
(type power)
- (7) electric log             
(yes or no)  
            
(organization running log)
- (8) how well bottom plugged VALVE

description of formations encountered	from	to
<u>Clay lt sand</u>	<u>6</u>	<u>8</u>
<u>Sand clay</u>	<u>8</u>	<u>40</u>
<u>Sand lt shale</u>	<u>40</u>	<u>52</u>
<u>Sand lt shale</u>	<u>52</u>	<u>105</u>
<u>Sand lt shale</u>	<u>105</u>	<u>118</u>
<u>Sand lt shale</u>	<u>118</u>	<u>140</u>
<u>Coarse sand</u>	<u>140</u>	<u>150</u>

**CODED**

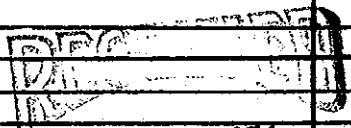

MAY 28 1974

MISS. BD. OF WATER COMM

DRILLERS REMARKS: