

County: Lauderdale
 Permit #: _____
 Driller: McDonald & Hill
 Date drilling completed: 8/10/13

STATE WELL REPORT

Part 1

Driller's Log
 Mississippi Department of Environmental Quality
 Office of Land and Water Resources
 P.O. Box 2309
 Jackson, MS 39225-2309
 (601)961-5210
 (601)360-0535 (fax)

For Office Use Only:
 Well #: D118
 Aquifer: _____
 E-Log #: _____

State Law requires that this report be prepared by the license holder responsible for the work and filed with the Department at the above address within 30 days of completion of drilling of the well or borehole.

#2

Well Owner Information (Landowner if borehole is not for a water well)	Well or Borehole Location
Owner Name: <u>Charles Pierce</u>	Latitude: <u>32-29-58</u> Longitude: <u>88-35-29</u>
Mailing Address: <u>9110 Chip Pickens Dr.</u>	Method of Lat/Long (check one): Conventional Survey _____ USGS quad _____, Hand-held GPS _____, Survey-grade GPS _____
<u>Meridian</u> MS <u>39305</u>	<u>NE 1/4 NE 1/4, Sec 32 T 8N R 17E</u>
City State Zip Code	<u>31</u> Miles or _____ (Distance) (Direction) (Nearest Town)
Telephone No. <u>(601) 527-7799</u>	

Well / Borehole Data

Date drilling started: 8/1/13 Date drilling completed: 8/10/13 Hole depth: 360 Hole diameter: 7

Location of the source of any surface water used for drilling: Community

Method of dosing and volume of Chlorine used in drilling and development: 1 lb per 1,000 gallons

Logs run (circle all applicable): No log run Electric Gamma Ray Density Sonic Neutron Other: _____

Name of organization running log(s): _____

Purpose of borehole (circle one): Water Well Geotechnical/Geological investigation Ground Source Heat Pump
 Seismic Survey Other (describe) _____

If drilling is not related to water well construction, skip the remainder of this block

Purpose of Well (circle all applicable): Home Industrial Public Supply Irrigation Fish Culture

Other (describe): _____

If a flowing well, method of flow regulation: Valve _____ Other (describe) _____

Static Water Level: 170 feet (above or below) land surface Date measured: 8/10/13
(circle one)

Method of measurement (circle one): Steel tape Electric tape Air line Other (describe): _____

Well depth: 360 Well grouted to a depth of: 10 feet Type of grout (circle one): Neat Cement Bentonite Mix

Casing length: 340 feet Casing diameter: 4 inches Type of casing: PVC

Screen length: 20 feet Screen diameter: 4 inches Type of screen: PVC

Screen slot size: 0010 inches Setting depth: From 300 ³⁴⁰ feet to 340 ³⁶⁰ feet

Type of completion (circle all applicable): Gravel packed Underreamed Open hole Natural Development

Other (describe): Sand packed

Top of lap pipe or reduction in casing: _____ feet

If telescoped or more than one screen, describe on next page

RECEIVED
 BY: [Signature]


County: Lauderdale
 Permit #: _____

For Office Use Only:
 Well #: D118

The sketch below only required for water wells
 If well telescopes, show depths on sketch.


Description of formations encountered must be provided for all wells
 and boreholes, unless specifically exempted by regulations

#2

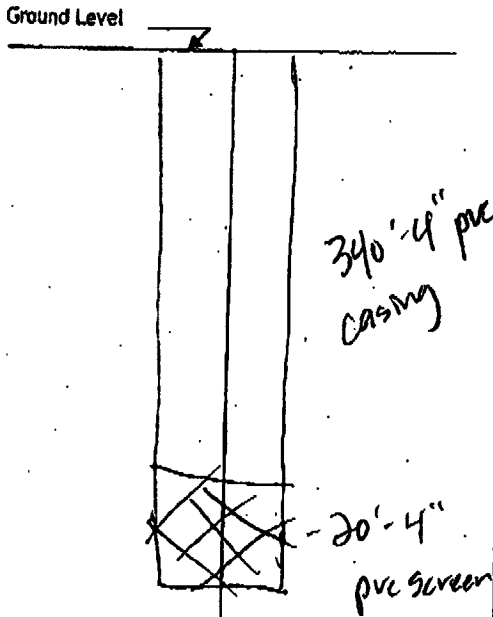

Description of Formations Encountered	From (depth)	To (depth)
Sand	Ground level	20
shale	20	40
Sandy shale	40	130
Coarse sand	130	170
Sandy shale	170	230
Sand/Coarse sand	230	310
Sandy shale	310	320
Sand/Coarse sand	320	300

If more than one screen, show location of each on sketch

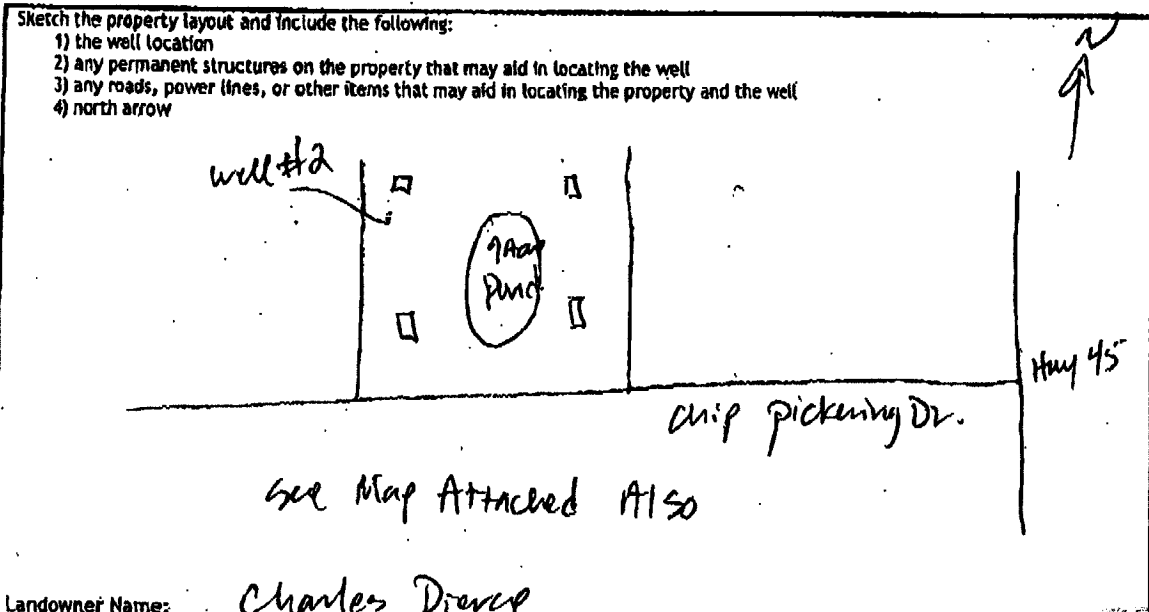

I HEREBY CERTIFY that the well/borehole was drilled, constructed, and completed in accordance with all applicable requirements of the Mississippi Department of Environmental Quality and the Mississippi Department of Health regulations, if applicable, and state laws.

McDonald & Hill #0-8 9/27/13 Harold Hill
 Print Name of Responsible Licensee and License No. Date Signature of Licensee

RECEIVED
 09 27 2013
 OLWR

RECEIVED
BY: OLWR

STATE WELL REPORT

Part 2

Pump Installer's Completion Report
Mississippi Department of Environmental Quality
Office of Land and Water Resources
P.O. Box 2309
Jackson, MS 39225-2309
(601)961-5210
(601) 360-0535 (fax)

County: Lauderdale
 Permit #: _____
 Driller: McDonald & Hill
 Date completed: 9/9/13
Copy information from block on Part 1

For Office Use Only:
 Well #: D118
 Aquifer: _____

#2

This part of the report must be completed by a licensed water well contractor or a licensed pump installer. A copy of Part 1 of the report must be attached and both parts filed with the Department at the above address within 30 days of well completion.

Well Owner Information		Well Location	
Owner Name: <u>Charles Pierce</u>	Latitude: _____	Longitude: _____	
Mailing Address: <u>910 Chip Pickens Rd</u>	Method of Lat/Long (check one): Conventional Survey _____		
<u>Menden</u> <u>MS</u> <u>3905</u>	USGS quad _____, Hand-held GPS _____, Survey-grade GPS _____		
City State Zip Code	_____ 1/4 _____ 1/4, Sec <u>32</u> T <u>8N</u> R <u>17E</u>		
Telephone No. <u>(601) 577-7799</u>	_____ Miles _____ of _____ (Distance) (Direction) (Nearest Town)		

Pump Type (circle one)
 Submersible Turbine Air Lift Centrifugal Flowing Well Jet Piston Rotary Other (describe): _____

Date Pump Installed: 8/7/13 Rated Pump Capacity: 25 Gallons Per Minute

Is This Pump (circle one): New Repaired Replacement

Power Type (circle one)
 Electric Diesel Gasoline Natural Gas Tractor PTO Windmill Other (describe): _____

Horse Power Rating of Motor: 3HP Setting Depth: 100 feet Number of Stages: _____

Pump Test Data for Non Flowing Well

Date Well Tested: 8/8/13 Duration of Pump Test (minimum 4 hours): 4 hours

Static Water Level (A): 120 Feet Below Land Surface Pumping Water Level (B): 140 Feet Below Land Surface

Drawdown [(B) - (A)]: 20 Feet Below Land Surface Test Pumping Rate: 25 Gallons Per Minute

Method of measurement (circle one): Steel tape Electric tape Air line Other (describe): _____

Pump Test Data for Flowing Well

Measured shut in head: _____ feet.

Well yielded _____ GPM with a drawdown of _____ feet after _____ hours of pumping

Meter Installation

Meter Manufacturer: _____ Meter Serial Number: _____

Meter Model Number/Name: _____ Type of Meter: _____

Totalizer Register Unit and Multiplier Factor (AF x .001, gal x 1000, etc): _____

Installation Date: _____ Meter Installed by: _____

Is This Meter (circle one): New Repaired Replacement

Important: By submitting the above information you are certifying that this meter was installed to manufacturer standards. For agricultural wells, a list of approved meters is on the MDEQ website.

I HEREBY CERTIFY that the above statements are true to the best of my knowledge.

McDonald & Hill #02 8/27/13 [Signature]

Print Name of Pump Installer and License No. (if applicable) Date Signature of Pump Installer