

Lauderdale
D 2037

MISSISSIPPI
 BOARD OF WATER COMMISSIONERS
 416 North State Street
 Jackson, Mississippi 39201

WATER WELL DRILLERS LOG

5-5-80
5/57 19*80* *Jerry Drilling Co.* *Laud*
 date well completed firm name county well located

LANDOWNER:	description of formations encountered	from	to
<i>Herman A. Brown</i>	<i>yellow sand</i>	<i>0</i>	<i>65</i>
<i>Rt 8, Mn. Miss.</i>	<i>clay</i>	<i>65</i>	<i>150</i>
(mailing address)	<i>gravel</i>	<i>150</i>	<i>200</i>
	<i>shale</i>	<i>200</i>	<i>220</i>
	<i>shale</i>	<i>220</i>	<i>250</i>

WELL LOCATION:
 sec. *32* T *8* N R *17* E
1/2 miles *E* of *Lockhart*
 (distance) (direction) (nearest town)

WELL PURPOSE:
 (home, irrigation, municipal, industrial)

WELL COMPLETION DATA:

(1) diameter (inches) *4"*

(2) total depth (feet) *256*

(3) static water level (feet) *105* below above top of ground

(4) casing *VC 235*
 (material) (depth)

(size) if telescope see back.

(5) screen _____
 (length) (depth to top)

(size) (material)


(6) pump *1/2* *5*
 (HP) (yield gpm)

sub
 (type power)

(7) electric log _____
 (yes or no)

(organization running log)

(8) how well bottom plugged *open*

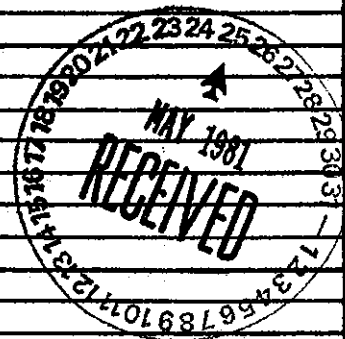

DRILLERS REMARKS: