

MISSISSIPPI DEPARTMENT OF NATURAL RESOURCES

Bureau of Land and Water Resources

COUNTY WELL LOCATED LAUD	
WELL NUMBER D 2074	CODED
DATE WELL COMPLETED 3/13/87	

PERMIT NUMBER D-55
NAME OF DRILLING FIRM TERRY DRIG Co., INC.
RT# Box 28 MDN, Miss

P.O. Box 10631
Jackson, Mississippi 39209
WATER WELL DRILLERS LOG

NAME & MAILING ADDRESS OF LANDOWNER LEWIS CLAYTON		
RT 2		
LAUDERDALE, Miss.		
WELL LOCATION: SEC	TOWNSHIP	RANGE
22	8	17
	S	W
DISTANCE	DIRECTION	NEAREST TOWN
2 Miles	SW	of LAUDERDALE
OTHER LANDMARK		
WELL PURPOSE: <input checked="" type="checkbox"/> Irrigation, Municipal, Industrial, Fish Pond, etc.		

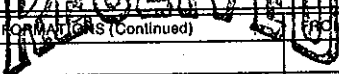
PUMP DATA		
PUMP TYPE (Circle One): Submersible, Turbine, <input checked="" type="checkbox"/> Jet, Flowing Well, Other (Describe)		
POWER TYPE (Circle One): <input checked="" type="checkbox"/> Electric, Tractor, Diesel, Gasoline, Butane, Other (Describe)		
Pump Capacity (GPM) 5-7	No. of Stages 2	Setting Depth 40 FT.
PUMP TEST		
Well yielded 5-7 GPM with a drawdown of _____ ft. after _____ hours of pumping		

WELL DATA		
Well Depth 100	Casing Diameter (In.) 2	Casing Length (Ft.) 90
Type of Casing PVC	Hole Depth 100	Depth to Static Water Level 10
TYPE OF COMPLETION: (Circle One or More): <input checked="" type="checkbox"/> Gravel Packed, <input type="checkbox"/> Underreamed, <input type="checkbox"/> Telescoped, <input checked="" type="checkbox"/> Natural Development, <input type="checkbox"/> Open Hole, <input type="checkbox"/> Other (Describe)		
Top of Lap Pipe or Reduction in Casing FEET IF TELESCOPED OR MORE THAN ONE SCREEN: USE BACK PAGE		

LOG DATA	
TYPE OF LOG RUN (Circle One): Electric, Gamma Ray, Density, Sonic, <input checked="" type="checkbox"/> No Log Run, Neutron, Other (Describe)	
Name of Organization Running Log	

GEOLOGIC DATA (Office Use Only)			
Surface Elev.	Geologic Unit	Unit Thickness	Depth to Top
Subs. SWL	Date	Analysis	Aquifer Test
Driller's Remarks			

SCREEN DATA		
Diameter - Inches 2	Length - Feet 10	Slot Size - Inches .012
Screen Type PVC	Depth to Bottom - Feet 100	

DESCRIPTION OF FORMATIONS ENCOUNTERED	FROM	TO	FORMATIONS (Continued)	FROM	TO
yellow Clay	0	25	 DEC 13 1987 Department of Natural Resources Bureau of Land & Water Resources		
sandy Clay	25	40			
Clay	40	80			
sand	80	100			

IF MORE SPACE IS NEEDED, USE BACK