

**L.A.U.D.
E1**

WATER WELL DRILLERS LOG

9

Date: 9-21-64 1964, Driller: M. McDonald & H. J. Tr County Lauderdale

(Name)

(1) Owner of Land: T. L. STEWART

(Name)

1432-47th Ave

(Address)

New Iberia, Miss

(2) Location: 1/4, 1/4, Sec. 30 T 8N R 18W

1 miles S.E. of Lauderdale
(distance) (direction) (Nearest Town)

(3) Topography: (Hilly) (Flat) (Level)

(4) Purpose of Well: Domestic
(Domestic Irrigation, Municipal, Industrial, Other)

Description & Color of Materials Sand, Clay, Red Clay, Shell, etc.	Thick- ness Feet	Depth Feet
SAND ST CLAY	0	40
SHALE	40	80
SHALE ST SAND	80	120
SAND	120	140


Information upon completion of well:

- (1) Diameter inches.
- (2) Total Depth 140' feet.
- (3) Water Level 20' feet below top of ground.
- (4) Cased to 74', Size 4"
65' 2"
- (5) Screen: Size 2", Length 4' BRASS
- (6) Were any formations sealed against pollution?
 yes, no.

If YES depth of formation

Why

Drillers Remarks:

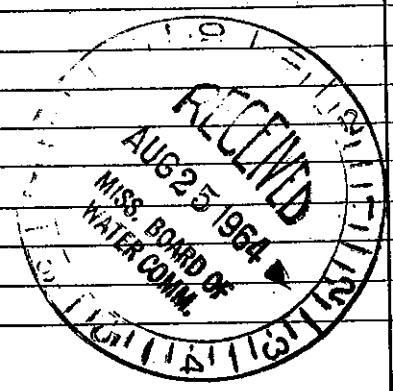

(Use Back Side)

Well No.

Mail this copy to Board of Water Commissioners 429 Miss. St. Jackson, Miss