

LAUD. MISSISSIPPI BOARD OF WATER COMMISSIONERS

E2
9-19-64

WATER WELL DRILLERS LOG

Date: 9-19-1964, Driller: M. S. Donnell & Hill, Inc. County _____
(Name)

	Description & Color of Materials Sand, Clay, Red Clay, Shell, etc.	Thick- ness Feet	Depth Feet
(1) Owner of Land: J. B. Gough (Name) Dalewood Lake (Address)	SAND CLAY	0	35
(2) Location: _____ 1/4, _____ 1/4, Sec. _____ T. R. _____	SAND	35	67
_____ 1 miles S.E. of Lumberton (distance) (direction) (Nearest Town)			
(3) Topography: X (Hilly) (Flat) (Level)			
(4) Purpose of Well: DOMESTIC (Domestic Irrigation Municipal, Industrial, Other)			

Information upon completion of well:

(1) Diameter 34 TEST HOLE inches.

(2) Total Depth 130' feet.

(3) Water Level 15' feet below top of ground.

(4) Cased to 126', Size 2"


(5) Screen: Size 2", Length 4" BRASS

(6) Were any formations sealed against pollution?
_____ yes, _____ no.

If YES depth of formation _____

Why _____

Drillers Remarks: _____

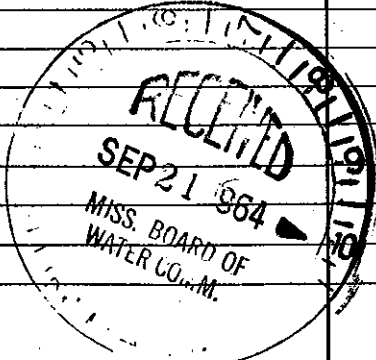

(Use Back Side)

Well No. _____

Mail this copy to Board of Water Commissioners 429 Miss. St. Jackson, Miss.