

LAUD.

E3

MISSISSIPPI BOARD OF WATER COMMISSIONERS

7-20-66

WATER WELL DRILLERS LOG

Date: 7-20, 1966, Driller: McDONALD + HILL County LAUD.

(When well drilled)

(Name)

(Where well is located)

(1) Owner of Land: HAROLD POPE (Name)	Description & Color of Materials Sand, Clay, Red Clay, Shell, etc.	Thick- ness Feet	Depth Feet
DALEWOOD SHORE LAKE (Address)	SAND	0	25
(2) Location: 1/4, 1/4, Sec. T R,	CLAY + SAND	25	72
2 miles S.E. of Lawrenceville (distance) (direction) (Nearest Town)	SHALE	72	90
(3) Topography: HILLY (Hilly) (Flat) (Level)	FINE SAND SHALE	90	95
(4) Purpose of Well: DOMESTIC (Domestic Irrigation Municipal, Industrial, Other)	C SAND	95	105
	SAND M TO FINE	105	125
	SHALE	125	135
	C SAND	135	155

Information upon completion of well:

- (1) Diameter 2 inches.
- (2) Total Depth 155 feet.
- (3) Water Level 68 feet below top of ground.
- (4) Cased to 147, Size 2
- (5) Screen: Size 2, Length 4
- (6) Were any formations sealed against pollution?
yes, no.


If YES depth of formation

Why

Drillers Remarks:

Flow in gpm:

Temp:

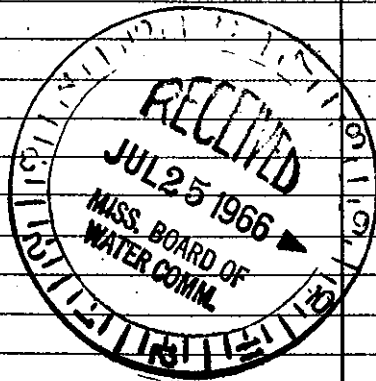

As copy for your office files.