

LAUD.

MISSISSIPPI BOARD OF WATER COMMISSIONERS

E6

WATER WELL DRILLERS LOG

3-19-65

Date: 3-19, 1966, Driller: McDonald & Hill, County: Lauderdale

(1) Owner of Land: Charles Howard
 (Name)
 Lauderdale, Miss.
 (Address)

(2) Location: 1/4, 1/4, Sec. 27 SW18E T. R.
 4 miles SE of Lauderdale
 (distance) (direction) (Nearest Town)

(3) Topography: (Hilly) (Flat) (Level)

(4) Purpose of Well: Domestic
 (Domestic Irrigation, Municipal, Industrial, Other)

Description & Color of Materials Sand, Clay, Red Clay, Shell, etc.	Thick- ness Feet	Depth Feet
Clay & Sand	0	20
Yellow C Sand	20	45
Shale	45	58
C white shale	58	83
Shale & sand sh	83	90


Information upon completion of well:

- (1) Diameter 2 inches.
- (2) Total Depth 90 feet.
- (3) Water Level 8 feet below top of ground.
- (4) Cased to 63, Size 2"
- (5) Screen: Size _____, Length _____.
- (6) Were any formations sealed against pollution?
 _____ yes, _____ no.

If YES depth of formation _____

Why _____

Drillers Remarks: _____

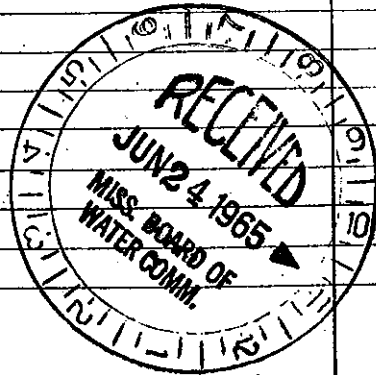

(Use Back Side)

Well No. _____