

LAUDERDALE
E 16
6-1-74

MISSISSIPPI
 BOARD OF WATER COMMISSIONERS
 416 North State Street
 Jackson, Mississippi 39201


CODED

WATER WELL DRILLERS LOG

6-1-74 19 McDonald + Hill LAUDERDALE
 date well completed firm name county well located

LANDOWNER:	description of formations encountered	from	to
JERRY MERCER			
	SHALE	12	30
	SAND	30	42
	SHALE	42	90
	SHALE ST SAND	90	130
	SAND	130	150
(mailing address)			
WELL LOCATION:			
sec 32-T 8 N R 18 E			
3 miles NORTH of Toomsoba			
(distance) (direction) (nearest town)			
WELL PURPOSE: HOME			
(home, irrigation, municipal, industrial)			
WELL COMPLETION DATA:			
(1) diameter (inches) 4"			
(2) total depth (feet) 150'			
(3) static water level (feet) 50' below top of ground			
(4) casing PVC 125' (material) (depth)			
4" (size) if telescope see back.			
(5) screen 6 144' (length) (depth to top)			
2 PVC (size) (material)			
(6) pump 1/2 HP 10 (HP) (yield gpm)			
F (type power)			
(7) electric log (yes or no)			
(organization running log)			
(8) how well bottom plugged VALUE			
DRILLERS REMARKS:			
24' = 2" PVC PIPE			
1 = 2 x 4 R SEAL			

CODED

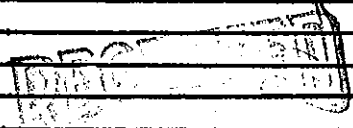

JUN 3 1974

WATER COMM