


Lauderdale
E 24
7/22/75

MISSISSIPPI
BOARD OF WATER COMMISSIONERS
416 North State Street
Jackson, Mississippi 39201
WATER WELL DRILLERS LOG

CODED

7-22 1975 McDonald + Hill Inc Lauderdale
date well completed firm name county well located

LANDOWNER:	description of formations encountered	from	to
Mary Lee Herlong Rt # 1 Box 152 Cuba, Ala (mailing address)			
WELL LOCATION: sec. 25 T 8 S R 18 E 13K 0.6 miles east of Lauderdale (distance) (direction) (nearest town)			
WELL PURPOSE: home (home, irrigation, municipal, industrial)			
WELL COMPLETION DATA:			
(1) diameter (inches) 4"			
(2) total depth (feet) 80'			
(3) static water level (feet) 14' below top of ground			
(4) casing 4" PVC 21' (material) (depth) no if telescope see back. (size)			
(5) screen no (length) (depth to top) (size) (material)			
(6) pump (HP) (yield gpm) (type power)			
(7) electric log no (yes or no) (organization running log)			
(8) how well bottom plugged open end			
DRILLERS REMARKS: none			

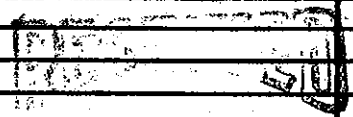

JUL 28 1975

MISS. BD. OF WATER COMM