

LAUDERDALE

E 2013

08/01/75

MISSISSIPPI  
 BOARD OF WATER COMMISSIONERS  
 416 North State Street  
 Jackson, Mississippi 39201

WATER WELL DRILLERS LOG

date well completed

firm name

county well located

1975 Mc Donald & Miller Lauderdale

LANDOWNER: R.C. Gibbs

Rt #1

description of formations encountered

Clay & sand

from

to

0

40

Cuba Ala

(mailing address)

course sand ST clay

40

63

43

83

WELL LOCATION:

sec. 39 T. 8 N R. 17 E

8 1/2 miles east of Lauderdale

WELL PURPOSE: home (home, irrigation, municipal, industrial)

WELL COMPLETION DATA:

- (1) diameter (inches) 2
- (2) total depth (feet) 43
- (3) static water level (feet) 46 below top of ground
- (4) casing 2" PVC 78' (material) (depth)

If telescope see back. (size)

- (5) screen 5' 78' (length) (depth to top)
- 2" Plastic (size) (material)


- (6) pump (HP) (yield gpm)
- (type power)

- (7) electric log (yes or no)

(organization running log)

- (8) how well bottom plugged back pressure valve

DRILLERS REMARKS: none

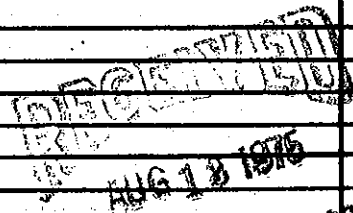

MISS. BD. OF WATER COMMISSIONERS