

Bureau of Land and Water Resources
 Southport Mall
 P.O. Box 10631
 Jackson, Mississippi 39209
WATER WELL DRILLERS LOG

LAUDERDALE
E 2009

Aug 5 1986 McDonald & Hite Laurens
 date well completed firm name county well located


AND OWNER: Henry King
P.O. Box 173
Laurens, MS.
 (mailing address)

description of formations encountered	from	to
<u>Clay SAND</u>	<u>0</u>	<u>40</u>
<u>SHALE</u>	<u>40</u>	<u>50</u>
<u>SAND</u>	<u>50</u>	<u>85</u>
<u>SHALE</u>	<u>85</u>	<u>110</u>
<u>Coarse SAND</u>	<u>110</u>	<u>140</u>

WELL LOCATION:
T-80N R-18E
1 1/2 miles E of Laurens
 (distance) (direction) (nearest town)

WELL PURPOSE:
 (home, irrigation, municipal, industrial)

WELL COMPLETION DATA:
) diameter (inches) 2"
) total depth (feet) 140
) static water level (feet) 73 below above top of ground.
) casing PVC 130
 (material) (depth)
2 if telescope see back.
 (size)
) screen 10 ft. 130
 (length) (depth to top)
2 PVC
 (size) (material)
) pump 10
 (HP) (yield gpm)
 (type power)
) electric log _____
 (yes or no)
 (organization running log)
) how well bottom plugged _____

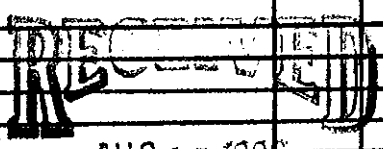

Department of Natural Resources
 Bureau of Land & Water Resources

DRILLERS REMARKS: