

MISSISSIPPI BOARD OF WATER COMMISSIONERS

LAUD.

F1

6-12-64

WATER WELL DRILLERS LOG

10

Date: 6-12, 1964, Driller: Bob Wilkinson County Lauderdale  
(Name)

	Description & Color of Materials Sand, Clay, Red Clay, Shell, etc.	Thick- ness Feet	Depth Feet
(1) Owner of Land: <u>E. J. Reed</u> (Name) <u>Collinsville, Miss.</u> (Address)	<u>Red Clay</u>	<u>10</u>	<u>1-10</u>
	<u>Blue Clay</u>	<u>10</u>	<u>10-20</u>
	<u>White Chalk</u>	<u>38</u>	<u>20-50</u>
(2) Location: <u>SE 1/4, NW 1/4, Sec. 1 T. 2 R. 14</u> <u>10</u> miles <u>N, W</u> , of <u>Meridian</u> (distance) (direction) (Nearest Town)	<u>Blue Clay</u>	<u>10</u>	<u>50-60</u>
	<u>fine white sand</u>	<u>15</u>	<u>60-75</u>
	<u>Blue Clay and</u>	<u>32</u>	<u>75-107</u>
(3) Topography: <u>Hilly</u> (Hilly) (Flat) (Level)	<u>fine white sand</u>	<u>35</u>	<u>107-142</u>
	<u>white sand</u>	<u>28</u>	<u>142-170</u>
(4) Purpose of Well: <u>Domestic</u> (Domestic Irrigation Municipal, Industrial, Other)	<u>Blue Clay</u>	<u>21</u>	<u>170-191</u>
	<u>White sand</u>	<u>21</u>	<u>191-212</u>
	<u>Blue clay</u>		


Information upon completion of well:

- (1) Diameter 2 inches.
- (2) Total Depth 212 feet.
- (3) Water Level \_\_\_\_\_ feet below top of ground.
- (4) Cased to 147, Size 2 in.
- (5) Screen: Size 0, Length \_\_\_\_\_.
- (6) Were any formations sealed against pollution?  
 yes, \_\_\_\_\_ no.

If YES depth of formation 60 to 75 ft.

Why iron water

Drillers Remarks: \_\_\_\_\_

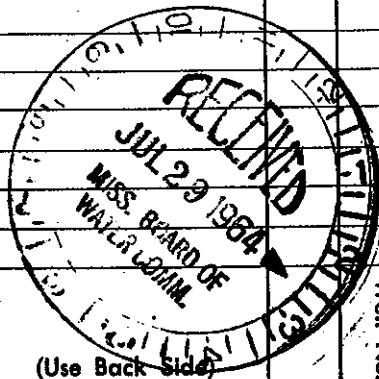

Well No. \_\_\_\_\_

(Use Back Side)

Retain this copy for your office files.