

LAUD.

BOARD OF WATER COMMISSIONERS

AF2

### WATER WELL DRILLERS LOG

11-29-63

Date: 11-29, 1963, Driller: Norman Denny County Laud  
(Name)

| (1) Owner of Land   | Description & Color of Materials<br>Sand, Clay, Red Clay, Shell, etc. | Thick-<br>ness<br>Feet | Depth<br>Feet |
|---|---|------------------------|---------------|
| <u>Mr. Cecil Allen</u><br>(Name)  |   |                        |               |
| <u>Collinsville, Miss</u><br>(Address)  | <u>Sandy</u>  | <u>0</u>               | <u>120</u>    |
| <u>7N 14E</u>   | <u>Shale + mud</u>  | <u>120</u>             | <u>280</u>    |
| (2) Location: <u>1/4, 1/4, Sec. 1</u> T R   | <u>Sandy - Grey</u>   | <u>280</u>             | <u>320</u>    |
| <u>8</u> miles <u>North</u> of <u>MDN</u><br>(distance) (direction) (Nearest Town)            |   |                        |               |
| (3) Topography: _____<br>(Hilly) (Flat) (Level)   |   |                        |               |
| (4) Purpose of Well: <u>Domestic</u><br>(Domestic Irrigation<br>Municipal, Industrial, Other) |   |                        |               |


#### Information upon completion of well:

- (1) Diameter 4 inches.
- (2) Total Depth 320' feet.
- (3) Water Level 60 feet below top of ground.
- (4) Cased to 149', Size 4"
- (5) Screen: Size No, Length \_\_\_\_\_
- (6) Were any formations sealed against pollution?  
 yes,  no.

If YES depth of formation 120'

Why Sandy

Drillers Remarks: hard formation  
120-280'

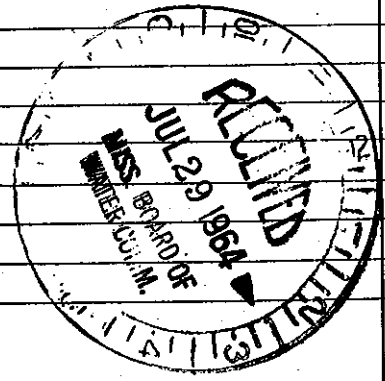

(Use Back Side)

Well No.

Retain this copy for your office files.