

Lauderdale  
 F7  
 1-67

MISSISSIPPI BOARD OF WATER COMMISSIONERS

WATER WELL DRILLERS LOG

Date: 1-5, 1967, Driller: M. Donald Hill of Hill County, Lauderdale  
(When well drilled) (Name) (Where well is located)

(1) Owner of Land: <u>BEN AGNEW</u> <small>(Name)</small>	Description & Color of Materials Sand, Clay, Red Clay, Shell, etc.	Thick- ness Feet	Depth Feet
<u>COLLINSVILLE MISS</u> <small>(Address)</small>	<u>SAND CLAY</u>	<u>40</u>	<u>40</u>
(2) Location: <u>NE 1/4, NE 1/4, Sec. 1</u> <u>N E</u> <u>T7 R14</u>	<u>SHALE</u>	<u>50</u>	<u>90</u>
<u>3</u> miles <u>S. EAST</u> , of <u>COLWYNSVILLE</u> <small>(distance) (direction) (Nearest Town)</small>	<u>FINE SAND</u>	<u>50</u>	<u>140</u>
(3) Topography: <u>X</u> <small>(Hilly) (Flat) (Level)</small>	<u>SHALE</u>	<u>50</u>	<u>190</u>
(4) Purpose of Well: <u>DOMESTIC</u> <small>(Domestic Irrigation Municipal, Industrial, Other)</small>	<u>FINE SAND ST SHALE</u>	<u>50</u>	<u>240</u>

Information upon completion of well:

(1) Diameter 3 7/8 inches. TEST HOLE

(2) Total Depth 240' feet.

(3) Water Level 103' feet below top of ground.

(4) Cased to 152', Size 4"  
OPEN WELL

(5) Screen: Size \_\_\_\_\_, Length \_\_\_\_\_.

(6) Were any formations sealed against pollution?  
 \_\_\_\_\_ yes, X no.

If YES depth of formation \_\_\_\_\_


Why \_\_\_\_\_

Drillers Remarks: \_\_\_\_\_

Yield in gpm: 30

Size pump: \_\_\_\_\_

Type power: \_\_\_\_\_

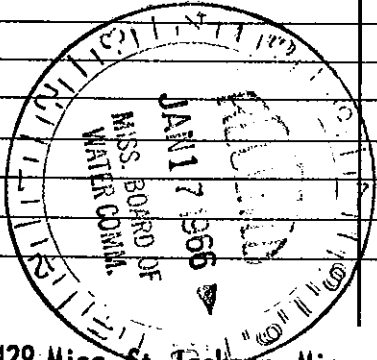

Mail this copy to Board of Water Commissioners 429 Miss. St. Jackson, Miss.