

LAUD.  
G.F.9  
6-27-61

MISSISSIPPI BOARD OF WATER COMMISSIONERS G?

WATER WELL DRILLERS LOG Lauderdale


Date: 6/27, 1961, Driller: Hester Ogilvie County ~~Arkola~~  
(Name)

	Description & Color of Materials Sand, Clay, Red Clay, Shell, etc.	Thick- ness Feet	Depth Feet
(1) Owner of Land: <u>Lloyd Cooksey</u> (Name) <u>Meridian, Miss</u> (Address)	<u>10 ft. clay &amp; sand</u> <u>60 ft. blue clay</u> <u>2.6 ft. water sand</u>		
(2) Location: <u>1/4, 1/4, Sec. 2</u> T R <u>8</u> miles <u>north west</u> of <u>Meridian</u> (distance) (direction) (Nearest Town)			
(3) Topography: <u>Hilly</u> (Hilly) (Flat) (Level)			
(4) Purpose of Well: <u>home use</u> (Domestic Irrigation Municipal, Industrial, Other)			

Information upon completion of well:

- (1) Diameter 6 1/2 inches.
- (2) Total Depth 96 feet.
- (3) Water Level 43 feet below top of ground.
- (4) Cased to 76, Size 4 in.
- (5) Screen: Size \_\_\_\_\_, Length \_\_\_\_\_.
- (6) Were any formations sealed against pollution?  
\_\_\_\_\_ yes, \_\_\_\_\_ no.

If YES depth of formation \_\_\_\_\_  
Why \_\_\_\_\_  
Drillers Remarks: \_\_\_\_\_

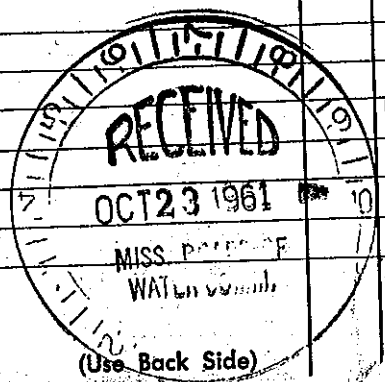

Mail this copy to Board of Water Commissioners 429 Miss. St. Jackson