

LAUDERDALE
F 11
11-67

MISSISSIPPI
BOARD OF WATER COMMISSIONERS
416 North State Street
Jackson, Mississippi 39201

WATER WELL DRILLERS LOG

11-1 - 1967 *Ferry Dilling* *Laud*
date well completed firm name county well located


LANDOWNER:
Mrs. Bonnie McDonald
RT 1, Collinsville, Miss
(mailing address)

description of formations encountered	from	to
<i>Yellow Clay</i>	<i>0</i>	<i>15</i>
<i>Sandy</i>	<i>15</i>	<i>40</i>
<i>Sandy shale</i>	<i>40</i>	<i>110</i>
<i>Hard shale</i>	<i>110</i>	<i>230</i>
<i>Sand streaks</i>	<i>230</i>	<i>280</i>

WELL LOCATION:
sec. *11* T. *7* N. R. *14* E
S W
9 miles *NW* of *MdN*
(distance) (direction) (nearest town)

WELL PURPOSE: *Home*
(home, irrigation, municipal, industrial)

- WELL COMPLETION DATA:
- (1) diameter (inches) *4"*
 - (2) total depth (feet) *280*
 - (3) static water level (feet) *45* ^{below} _{above} top of ground.
 - (4) casing *Blk 126'*
(material) (depth)
_____ if telescope see back.
(size)
 - (5) screen _____
(length) (depth to top)
(size) (material)
 - (6) pump *3/4* *6*
(HP) (yield gpm)
Jet
(type power)
 - (7) electric log *No*
(yes or no)
(organization running log)
 - (8) how well bottom plugged *open*
bottom

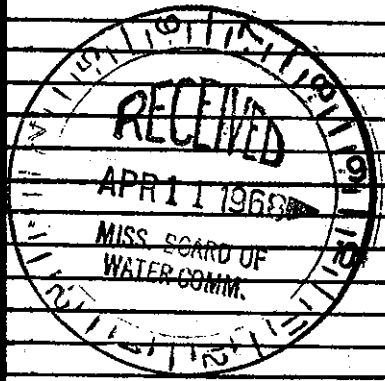

DRILLERS REMARKS: