

3 13P

SEE HILL FOR NAME YETU

322620 N 0885020

Lauderdale  
F14  
9-19-68

MISSISSIPPI  
BOARD OF WATER COMMISSIONERS  
416 North State Street  
Jackson, Mississippi 39201

WATER WELL DRILLERS LOG

CODED

9-19-68 date well completed  
McDONALD + HILL firm name  
LAUDERDALE county well located

LANDOWNER: F.W. Godwin

Rt # 2

Maudrain, Miss  
(mailing address)

WELL LOCATION:

sec. 23 T 2 N R 14 E  
S W

0 miles of (distance) (direction) (nearest town)

WELL PURPOSE: HOME  
(home, irrigation, municipal, industrial)

WELL COMPLETION DATA:


- (1) diameter (inches) 4"
- (2) total depth (feet) 420'
- (3) static water level (feet) 90' below top of ground.
- (4) casing BLACK 2 9/16" (material), (depth)  
4" (size) if telescope see back.
- (5) screen (length) (depth to top)  
(size) (material)
- (6) pump 3/4 (HP) 10 (yield gpm)  
220 (type power)
- (7) electric log NO (yes or no)  
NO (organization running log)
- (8) how well bottom plugged DP

description of formations encountered

from to

Sandy Clay	0	20
shale	20	60
sand	60	80
shale	80	100
fine sand	100	125
shale	125	140
soft sandy	140	160
shale	160	194
sand & shale	194	200
shale	200	230
sand	230	280
shale	280	350
sandy	350	380
shale	380	400
fine sand	400	420

CODED

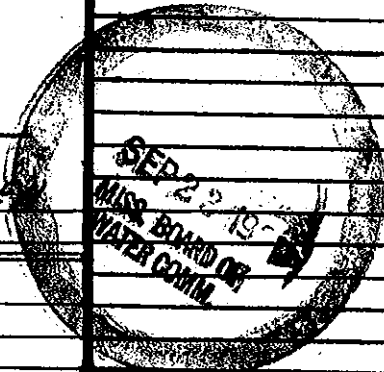

DRILLERS REMARKS: