

MISSISSIPPI BOARD OF WATER COMMISSIONERS

LAUD.

F32

WATER WELL DRILLERS LOG

**CODED**

1-24-63

Date: 1-24, 1963, Driller: McDonald & Hill, Inc. County: Laud.

(Name)

(1) Owner of Land:	Description & Color of Materials Sand, Clay, Red Clay, Shell, etc.	Thick- ness Feet	Depth Feet
Jerry Sissons (Name) Rt # 2 Enterprise (Address)	Clay	0	35
	B shale	35	55
(2) Location: 1/4, 23 7 1/4 Sec T R	Sand	55	90
7 miles S of Meridian	B. Shale	90	108
(3) Topography:	H. Shale	108	120
(Hilly) (Flat) (Level)	Shale w/ sand	120	125
(4) Purpose of Well: Domestic	Shale w/ lime	125	140
(Domestic Irrigation, Municipal, Industrial, Other)	Shale w/ soft lime	140	175
	Sandy shale	175	190
	Soft sand	190	210
	Tight sand	210	250

Information upon completion of well:


- (1) Diameter 4 inches.
- (2) Total Depth 250 feet.
- (3) Water Level 50 feet below top of ground.
- (4) Cased to 105, Size 4
- (5) Screen: Size \_\_\_\_\_, Length \_\_\_\_\_
- (6) Were any formations sealed against pollution?  
yes, no.

If YES depth of formation \_\_\_\_\_

Why \_\_\_\_\_

Drillers Remarks: \_\_\_\_\_

**CODED**

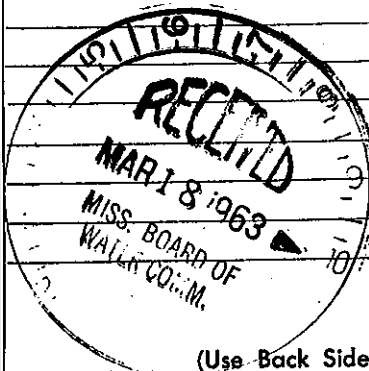

(Use Back Side)

Well No.

Mail this copy to Board of Water Commissioners 429 Miss. St. Jackson, Miss.