

MISSISSIPPI BOARD OF WATER COMMISSIONERS

WATER WELL DRILLERS LOG

CODED

LAUD.
F33
2-18-63

Date: 2-18, 1962, Driller: McDONALD & HILL, County: Madison

(Name)

(1) Owner of Land: A.M. McPhail
(Name)
Collinsville Miss.
(Address)

(2) Location: 1/4, 1/4, Sec. 714 T. 7 R. 13
(distance) miles (direction) of Enter (Nearest Town)

(3) Topography: (Hilly) (Flat) (Level)

(4) Purpose of Well: Domestic
(Domestic Irrigation, Municipal, Industrial, Other)

Description & Color of Materials Sand, Clay, Red Clay, Shell, etc.	Thick- ness Feet	Depth Feet
Clay	0	12
Shale	12	25
Sand	25	29
Shale	24	80
Shale	80	110
Shale	100 130	30
Sand	130	155
Shale	155	230
Shale	230	265
Shale	265	271
Sand	271	395
Sandy shale	395	402

Information upon completion of well:

(1) Diameter 4 inches.

(2) Total Depth 402 feet.


(3) Water Level 112 feet below top of ground.

(4) Cased to 273, Size _____

(5) Screen: Size _____, Length _____

(6) Were any formations sealed against pollution?
 yes, no.

CODED

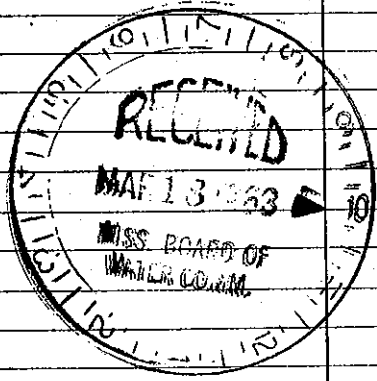

If YES depth of formation _____

Why _____

Drillers Remarks: _____

Well No.

(Use Back Side)

Retain this copy for your office files.