

LAUD. MISSISSIPPI BOARD OF WATER COMMISSIONERS

CODED

WATER WELL DRILLERS LOG

F34
8-21-63

Date: 8-21, 1963, Driller: M. Q. Donald & H. V. Fre, County Lauderdale

(Name)


(1) Owner of Land: J.A. STEPHENS
(Name)
14-#1
(Address)

(2) Location: 2 3/4 Sec. 7 14 T. R.
20 miles North of Manly, Miss.
(distance) (direction) (Nearest Town)

(3) Topography: X
(Hilly) (Flat) (Level)

(4) Purpose of Well: DOMESTIC
(Domestic Irrigation, Municipal, Industrial, Other)

Description & Color of Material Sand, Clay, Red Clay, Shell, etc.	Thick- ness Feet	Depth Feet
<u>FINE SAND</u>	<u>0</u>	<u>10</u>
<u>CLAY</u>	<u>10</u>	<u>25</u>
<u>CLAY</u>	<u>25</u>	<u>60</u>
<u>CLAY</u>	<u>60</u>	<u>70</u>
<u>CLAY</u>	<u>70</u>	<u>120</u>
<u>CLAY</u>	<u>120</u>	<u>125</u>
<u>CLAY</u>	<u>125</u>	<u>190</u>
<u>FINE SAND</u>	<u>190</u>	<u>240</u>

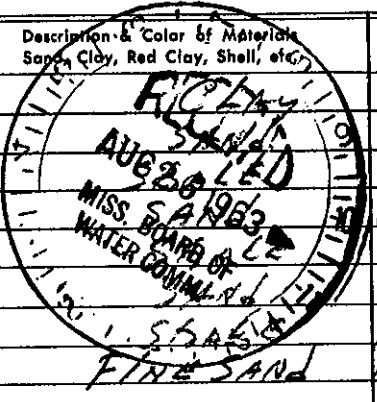

Information upon completion of well:

(1) Diameter 3 7/8 inches TEST HOLE

(2) Total Depth 240' feet.

(3) Water Level 110' feet below top of ground.

(4) Cased to 161', Size 4"

(5) Screen: Size _____, Length _____

(6) Were any formations sealed against pollution?
_____ yes, _____ no.

If YES depth of formation _____

Why _____

Drillers Remarks: _____

CODED

Well No.

(Use Back Side)