

LAUD.
F35
7-25-64

WATER WELL DRILLERS LOG **CODED**

Date: 7.25, 1964, Driller: M & Donald & H.W. Inc County Lauderdale
(Name)

(1) Owner of Land: G. McGEE
(Name)
Rt #2, Mendon
(Address)
23 714
(2) Location: $\frac{1}{4}$, 23 Sec. 714 T. R.
12 miles N.W. of Mendon
(distance) (direction) (Nearest Town)
(3) Topography: X
(Hilly) (Flat) (Level)
(4) Purpose of Well: Domestic
(Domestic Irrigation, Municipal, Industrial, Other)

Description & Color of Materials Sand, Clay, Red Clay, Shell, etc.	Thick- ness Feet	Depth Feet
CLAY	0	25
SHALE	25	40
SAND	40	45
SHALE	45	170
SAND & SHALE	170	210
SHALE	210	305
FINE SAND	305	320
SAND	320	340

Information upon completion of well:

(1) Diameter: 3 7/8 inches. TEST HOLE

(2) Total Depth: 340 feet.

(3) Water Level: 109' feet below top of ground.

(4) Cased to: 223, Size 4"


(5) Screen: Size ✓, Length ✓

(6) Were any formations sealed against pollution?
 yes, no.

If YES depth of formation _____

Why _____

Drillers Remarks: _____

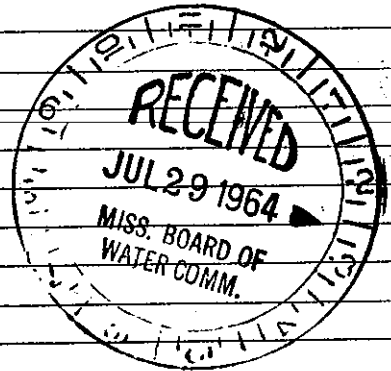

CODED

Well No.

(Use Back Side)

Mail this copy to Board of Water Commissioners 429 Miss. St. Jackson, Miss.