

LAUDERDALE
F 50
4-20-74

MISSISSIPPI
 BOARD OF WATER COMMISSIONERS
 416 North State Street
 Jackson, Mississippi 39201 **CODED**

WATER WELL DRILLERS LOG

4-20-74 date well completed 19Williamson Drilling Co. firm name Lauderdale county well located


LANDOWNER: <u>A.F. Irwin</u>	description of formations encountered	from	to
<u>of 2</u>	<u>top soil</u>	<u>0</u>	<u>2</u>
<u>Collinsville, Miss.</u> (mailing address)	<u>Blue Clay</u>	<u>2</u>	<u>18</u>
	<u>red sand</u>	<u>18</u>	<u>37</u>
	<u>Blue Clay</u>	<u>37</u>	<u>85</u>
	<u>sand</u>	<u>85</u>	<u>113</u>
	<u>Blue Clay & sand</u>	<u>113</u>	<u>180</u>
	<u>Blue Clay</u>	<u>180</u>	<u>260</u>
	<u>sand</u>	<u>260</u>	<u>311</u>

WELL LOCATION:
 sec 3 T 7N R 14E
2 miles south of Collinsville
 (distance) (direction) (nearest town)

WELL PURPOSE: Home
 (home, irrigation, municipal, industrial)

- WELL COMPLETION DATA:
- (1) diameter (inches) 4
 - (2) total depth (feet) 311
 - (3) static water level (feet) 80 ^{below} _{above} top of ground.
 - (4) casing Alastic 185
 (material) (depth)
 - 4 If telescope see back.
 (size)
 - (5) screen no
 (length) (depth to top)
 - (size) (material)
 - (6) pump 1
 (HP) (yield gpm)
 - Elect.
 (type power)
 - (7) electric log no
 (yes or no)
 - no
 (organization running log)
 - (8) how well bottom plugged open

CODED

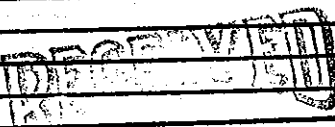

DEC - 9 1974

DRILLERS REMARKS:

MISS. BD. OF WATER COMM