
3 /	State W	ell Report		
County: LAUderSALE	P	art 1	For Office Use Only:	
Permit #:	Mississippi Department of Environmental Quality		Aquifer:	
Driller: McDonald & Hill, INC	Office of Land and Water Resources		Well #: F- 73	
Driller: // DONATE THIT, INC	P.O. Box 10631 Jackson, MS 39289-0631			
Date drilling completed: 4-23-07			L. S. Elevation:	
	_ (601)961-5210 _ (601)354-6938 (fax)		E-log #:	
State Law requires that this repo	of the well.	lriller in detail and filed w		
Well Owner Information		Well	Location	
Owner Name DANIEL Page	SEL !	Latitude:	" Longitude:° "	
Mailing Address: 4262 Hu	- 1011 'I	Method of Lat/Long (circle one		
		USGS quad, Hand-held	GPS. Survey-grade GPS	
Myladian, Ms	e Zip Code		Twn 7N Rng 14E	
Telephone No. 601) 917-6380		Distance Direction 3/2 Miles West o	Nearest Town of <u>SUQUOLENA</u>	
	Well Da	ıta		
Purpose of Well (circle and Hama)	will burners			
Purpose of Well (circle one Home Indu	_		Other:	
Date well drilling started: 7-23-	Date we	ell drilling completed:	24-07	
If flowing, method of flow regulation: Valv				
170	,		11 - 11 -	
1000 400		d surface Date measured:	724-07	
Method of Measurement (circle one) (stee				
Hole depth: 3/0 ' Well dept	h: 300 (Well grouted to a depth of	/Ofeet	
Type of grout (circle one): Cement	Bentonite Mix	•		
Casing length:feet	diameter:	inches Type of casing:	Prc	
Screen length: <u>20</u> feet Screer	54	inches Type of screen:/	PIC	
Screen slot size: #10inches	Setting depth: From		26 feet	
Type of completion (circle all applicable):	Gravel packed ' Underrea	uned Telescoped Open he	ole Natural Development	
	Other (describe):	•		
Top of lap pipe or reduction in casing:	10-1	coped or more than one scree	n describe on back of page	
Logs run (circle all applicable) No log run		•	I	
Name of organization running log(s):		,	.	
I certify that the well was drilled, construc	ted, and completed in acc	ordance with all applicable re	quirements of the Mississippi	
Department of Environmental Quality and	or the Mississippi Depar	tment of Health regulations or	nd state laws	
McDonald-Hill INC	# 0-8	An unol	(lion	
Print Name of Water Well Contractor and License No. Signature of Water Well Contractor				

If well telescopes please sketch below and show depths.

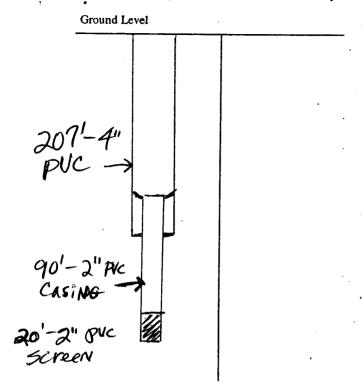

Description of Formations Encountered	From	То
SANDY	0	20
SHQLE / ,	20	150
SANdy Shale	140	S
USAND	bae	30
: SHale_	500	311
,		<u> </u>
		
		
		
		
·		
•		
	$\dashv \cdots \dashv$	
	_	

If more than one screen, show location of each on sketch

aid in	layout and include the following: 1) the well location; 2) any permanent structures on the property that ma locating the well; 3) any roads, power lines, or other items that may aid in locating the property and the wellicate direction.	ay ell;
		•
	o well nosile Home	,
	A-NEW culvert	
	Suqualona-Newton County RoAd	
ndowner Name: _	DANIEL PASEL	,

Signature of Water Well Contractor

RECEIVED

MAY 15 2007

BY: OLWP

STATE WELL REPORT

Part 2

Auderdale

County: _
Permit #:

Date completed: 2

Pump Installer's Completion Report
Mississippi Department of Environmental Quality
Office of Land and Water Resources

P.O. Box 10631 Jackson, MS 39289-0631 (601)961-5210 (601)354-6938 (fax)

For Office Use Only:				
Aquifer:				
Well #: F-73				
Elevation:				

(00)	1)354-0938 (fax)			
This report should be prepared by the pump installer in cinstallation of pump.	letail and filed with the Department within 30 days of the			
Well Owner Information	Well Location			
Owner Name: DANIEL PAGEL	Latitude: Longitude:			
Mailing Address: 4262 Hwy 19N				
	Method of Lat/Long (circle one): Conventional Survey,			
Meridia, Ms 392N	USGS quad, Hand-held GPS, Survey-grade GPS			
City State Zip Code	1/41/4 Sec			
Telephone No. (60) 917-6380	Distance Direction Nearest Town			
Telephone No. (601) 917-6380	31/2 Miles West of SuqualeNA			
Pump Type	Power Type			
Circle one	Circle one			
Air Lift Jet Submersible	Diesel Engine Gasoline Engine Natural Gas			
Bucket Piston Turbine	Electric Motor Hand Tractor PTO			
Centrifugal Rotary Flowing Well	Windmill Other (specify):			
Other (specify):	Horse Power Rating of Motor: 34 Hp			
Date Pump Installed: 4-24-07	Setting Depth: 200' feet			
Rated Pump Capacity:Gallons Per Minute	Number of Stages:			
Pump Test Data	Method of Measuring Water Level			
Date Well Tested: 4-24-67	Circle one			
Static Water Level (A): 70 Feet Below Land Surface	Air Line Electric Measuring Line Steel Tape			
Pumping Water Level (B):Feet Below Land Surface	Other (specify):			
Drawdown [(B) - (A)]: 20 Feet Below Land Surface	For flowing well, measured shut in head:feet			
Test Pumping Rate:	Well yielded GPM with a drawdown of			
Duration of Pump Test (minimum 4 hours):hours	. 10 feet after 3 hours of pumping			
I HEREBY CERTIFY that the above statements are true to the best of my knowledge.				
Harold Hill Etarold their				
Print Name of Pump Installer and License No. (if applicable) Signature of Pump Installer FIGURE 1				

MAY 15 2007

BY: OLWR