

**MISSISSIPPI
BOARD OF WATER COMMISSIONERS**
416 North State Street
Jackson, Mississippi 39201

WATER WELL DRILLERS LOG

LAUDERDALE
F 2021
5/21/81
5/21

81 McDonald & Hill Ave Laurel
firm name county well located

LANDOWNER: Willie Turner

description of formations encountered	from	to
<u>Clay & sand</u>	<u>0</u>	<u>60</u>
<u>Shale</u>	<u>60</u>	<u>200</u>
<u>St Sand & Shale</u>	<u>200</u>	<u>220</u>
<u>Shale</u>	<u>220</u>	<u>300</u>
<u>St Sand</u>	<u>300</u>	<u>400</u>


Rt # 6
Murikins, ms
(mailing address)

WELL LOCATION:
sec 23 T 1 N R 14 E
4 miles East of Verdeville
(distance) (direction) (nearest town)

WELL PURPOSE: Home
(home, irrigation, municipal, industrial)

WELL COMPLETION DATA:

- (1) diameter (inches) 4"
- (2) total depth (feet) 400
- (3) static water level (feet) 210 below top of ground.
- (4) casing 4" PVC 266'
(material) (depth)
- (size) if telescope see back.
- (5) screen (length) (depth to top)
- (size) (material)
- (6) pump 10
(HP) (yield gpm)
- (type power)
- (7) electric log (yes or no)
- (organization running log)
- (8) how well bottom plugged open

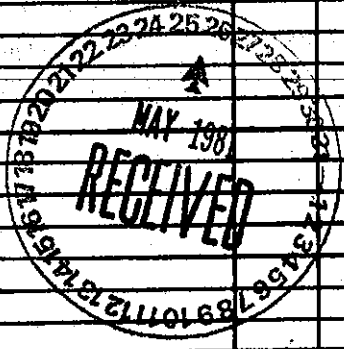

DRILLERS REMARKS: