

LANDOWNER
F 2035

MISSISSIPPI
BOARD OF WATER COMMISSIONERS
416 North State Street
Jackson, Mississippi 39201

WATER WELL DRILLERS LOG

~~March~~ March 1989 BEN ROOPE LAUDERDALE
date well completed: firm name county well located

LANDOWNER: MALCOLM LEWIS
Collinsville #1
MS, 39385
(mailing address)

WELL LOCATION:
(N 1/4)
sec. 12 T. 2 N. S. R. 14 E.
2 1/2 miles South of Collinsville
(distance) (direction) (nearest town)


WELL PURPOSE: HOME
(home, irrigation, municipal, industrial)

WELL COMPLETION DATA:

- (1) diameter (inches) 4"
- (2) total depth (feet) 415'
- (3) static water level (feet) 100' below above top of ground.
- (4) casing: 4" PVC 155'
(material) (depth)
 if telescope see back.
(size)
- (5) screen:
(length) (depth to top)
(size) (material)
- (6) pump 3/4 sub 12
(HP) (yield gpm)
220
(type power)
- (7) electric log NO
(yes or no)

(organization running log)
- (8) how well bottom plugged OPEN

description of formations encountered	from	to
Soil Red clay	0	12
gray shale	12	55
sand	55	72
shale	72	85
grey sand	85	125
black pepper spots		
fine sand		
shale	125	200
shale with	200	220
layers sandy shale		
shale with	220	415
lots of 16" layers of		
crusty or sandy shale		

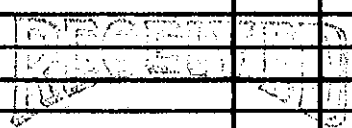

APR 10 1989

Department of Natural Resources
Bureau of Land & Water Resources

DRILLERS REMARKS:
good water