

MISSISSIPPI DEPARTMENT OF ENVIRONMENTAL QUALITY

Office of Land and Water Resources

P. O. Box 10631
Jackson, MS 39289-0631
WATER WELL DRILLERS LOG

COUNTY WELL LOCATED LARKEN	
WELL NUMBER F 2039	CODING
DATE WELL COMPLETED 4-23-93	

PERMIT NUMBER
NAME OF DRILLING FIRM POOLE WELL DRILLING

NAME & MAILING ADDRESS OF LANDOWNER Mrs. R. L. STEPHENS		
RT 3 Box 166		
Collinsville MS 39325		
WELL LOCATION: SEC	TOWNSHIP	RANGE
11	7 S	14 E
DISTANCE	DIRECTION	NEAREST TOWN
3 Miles	S	of Collinsville
OTHER LANDMARK MOSEBY CROSSING Rd.		
WELL PURPOSE (Home Irrigation, Municipal, Industrial, Fish Pond, etc.)		

PUMP DATA		
PUMP TYPE (Circle One): Submersible, Turbine, Jet, Flowing Well, Other (Describe) _____		
POWER TYPE (Circle One): Electric, Tractor, Diesel, Gasoline, Butane, Other (Describe) _____ H/P _____		
Pump Capacity (GPM) 14	No. of Stages	Setting Depth 100' FT.
PUMP TEST		
Well yielded 20 GPM with a drawdown of _____ ft. after _____ hours of pumping		

WELL DATA		
Well Depth 410'	Casing Diameter (In.) 4 1/2	Casing Length (Ft.) 145'
Type of Casing PVC	Hole Depth	Depth to Static Water Level 56'
TYPE OF COMPLETION: (Circle One or More): Gravel Packed, Underreamed, Telescoped, Natural Development, Open Hole , Other (Describe) _____		

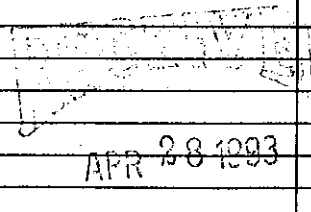
LOG DATA	
TYPE OF LOG RUN (Circle One): Electric, Gamma Ray, Density, Sonic, Neutron, Other (Describe) _____ No Log Run	
Name of Organization Running Log	

WELL GROUTED TO A DEPTH OF _____ FEET
Type Grout (circle one) Cement Bentonite, or Mix

GEOLOGIC DATA (Office Use Only)			
Surface Elev.	Geologic Unit	Unit Thickness	Depth to Top
Subs. SWL	Date	Analysis	Aquifer Test

SCREEN DATA		
Diameter - Inches	Length - Feet	Slot Size - Inches
Screen Type	Depth to Bottom - Feet	

Driller's Remarks			

DESCRIPTION OF FORMATIONS ENCOUNTERED	FROM	TO	FORMATIONS (Continued)	FROM	TO
TOP CLAY	0	8			
gray shale	8	60			
SHALE with	60	200			
SAND ST.	200	300			
SHALE some sand	200	360			
SAND	360	410			

IF MORE SPACE IS NEEDED, USE BACK