

LAUD. MISSISSIPPI BOARD OF WATER COMMISSIONERS

G2
5-20-64

WATER WELL DRILLERS LOG

12

Date: 5-20, 1964, Driller: Bob Williams County Lauderdale
(Name)

(1) Owner of Land: Bob Snowden
(Name)
Route # Meridian
(Address)

(2) Location: S 1/4, NE 1/4, Sec. 16 T. 7 R. 15
10 miles NW, of Meridian
(distance) (direction) (Nearest Town)

(3) Topography: Hilly
(Hilly) (Flat) (Level)

(4) Purpose of Well: Domestic
(Domestic Irrigation
Municipal, Industrial, Other)

Description & Color of Materials Sand, Clay, Red Clay, Shell, etc.	Thick- ness Feet	Depth Feet
<u>White sand</u>	<u>20</u>	<u>1-20</u>
<u>Blue clay</u>	<u>87</u>	<u>20-107</u>
<u>Gray sand</u>	<u>10</u>	<u>107-117</u>
<u>Blue clay</u>	<u>8</u>	<u>117-125</u>
<u>White sand</u>	<u>45</u>	<u>125-170</u>

Information upon completion of well:

(1) Diameter 4 inches.

(2) Total Depth 170 feet.

(3) Water Level 22 feet below top of ground.

(4) Cased to 38, Size 4 in.


(5) Screen: Size 0, Length _____

(6) Were any formations sealed against pollution?
X yes, _____ no.

If YES depth of formation 1 to 20 ft.

Why Iron water

Drillers Remarks: _____

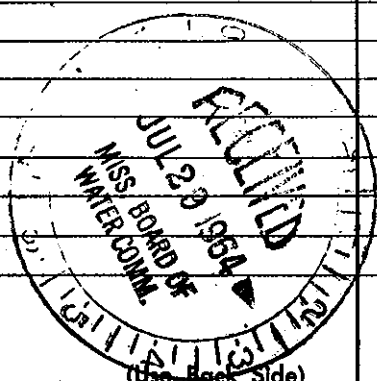

Well No.

Retain this copy for your office files.