

MISSISSIPPI BOARD OF WATER COMMISSIONERS

LAUD.

G3

WATER WELL DRILLERS LOG

13

Date: 6-16-64, 1964, Driller: Bob Williams County Lauderdale
(Name)

(1) Owner of Land: Stacy Snowden
(Name)
Route #2 Meridian
(Address)
(2) Location: SE 1/4, NW 1/4, Sec. 16 T7 R15
10 miles NW, of Meridian
(distance) (direction) (Nearest Town)
(3) Topography: flat
(Hilly) (Flat) (Level)
(4) Purpose of Well: Domestic
(Domestic Irrigation
Municipal, Industrial, Other)


Description & Color of Materials Sand, Clay, Red Clay, Shell, etc.	Thick- ness Feet	Depth Feet
<u>white sand</u>	<u>20</u>	<u>1-20</u>
<u>Blue clay</u>	<u>129</u>	<u>20-149</u>
<u>white sand</u>	<u>42</u>	<u>149-191</u>

Information upon completion of well:

(1) Diameter 4 inches.
(2) Total Depth 191 feet.
(3) Water Level 8 feet below top of ground.
(4) Cased to 38, Size 4"
(5) Screen: Size 0, Length _____
(6) Were any formations sealed against pollution?
✓ yes, _____ no.

If YES depth of formation 1-20 feet
Why Iron water

Drillers Remarks: _____

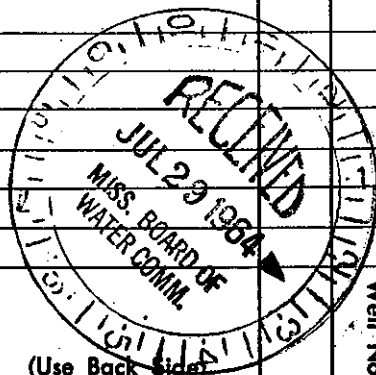

Well No.

in this copy for your office files.