

G6

10-10-60

WATER WELL DRILLERS LOG

2300

Date: Oct 10, 1960, Driller: Ferry Drilling Co County Lauderdale
 (Name)

	Description & Color of Materials Sand, Clay, Red Clay, Shell, etc.	Thick- ness Feet	Depth Feet
(1) Owner of Land: <u>A. L. Massey</u> (Name)	<u>Clay & yellow sand</u>	<u>0</u>	<u>32'</u>
<u>Bailey, Miss.</u> (Address)	<u>Gray sand</u>	<u>32'</u>	<u>66'</u>
(2) Location: <u>1/4, 1/4, Sec. T R</u>	<u>Gray mud</u>	<u>66'</u>	<u>88'</u>
<u>1</u> miles <u>So. East</u> , of <u>Bailey</u> (distance) (direction) (Nearest Town)	<u>Shakes sand & mud</u>	<u>88'</u>	<u>132</u>
(3) Topography: <input checked="" type="checkbox"/> (Hilly) <input type="checkbox"/> (Flat) <input type="checkbox"/> (Level)	<u>Tough blue mud</u>	<u>132</u>	<u>214</u>
(4) Purpose of Well: <u>Domestic</u> (Domestic Irrigation Municipal, Industrial, Other)	<u>Gray sand</u>	<u>214</u>	<u>256</u>


Information upon completion of well:

- (1) Diameter 3 inches.
- (2) Total Depth 256 feet.
- (3) Water Level 120 feet below top of ground.
- (4) Cased to 168, Size 3
- (5) Screen: Size open well, Length _____
- (6) Were any formations sealed against pollution?
 yes, no.

If YES depth of formation 168'

Why sealed in mud

Drillers Remarks: _____

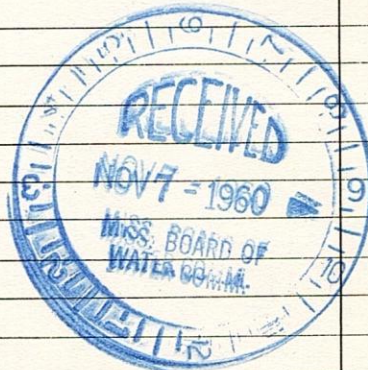

(Use Back Side)

Well No.

