

LAUD. MISSISSIPPI BOARD OF WATER COMMISSIONERS

G 10

3-16-64

WATER WELL DRILLERS LOG

Date: 3-16, 1964, Driller: Jerry County Laud

(1) Owner of Land:	Description & Color of Materials Sand, Clay, Red Clay, Shell, etc.	Thick- ness Feet	Depth Feet
<u>James Cuyppu</u> (Name)	<u>Red Clay + sand</u>	<u>0</u>	<u>40</u>
<u>Rt 2, Meridian</u> (Address)	<u>Sandy Slush</u>	<u>40</u>	<u>125</u>
(2) Location: <u>20 7N 15E</u> 1/4, 1/4, Sec. T. R.	<u>fine gray sand</u>	<u>125</u>	<u>230</u>
<u>5</u> miles <u>NW</u> of <u>MDN</u> (distance) (direction) (Nearest Town)	<u>yellow clay</u>	<u>230</u>	<u>350</u>
(3) Topography: <input checked="" type="checkbox"/> (Level) (Hilly) (Flat)	<u>sandy streaks</u>	<u>350</u>	<u>450</u>
(4) Purpose of Well: (Domestic Irrigation Municipal, Industrial, Other)			


Information upon completion of well:

- (1) Diameter 4 inches.
- (2) Total Depth 450 feet.
- (3) Water Level 44' feet below top of ground.
- (4) Cased to 234, Size 4"
- (5) Screen: Size No, Length _____
- (6) Were any formations sealed against pollution?
_____ yes, no.

If YES depth of formation _____

Why _____

Drillers Remarks: _____

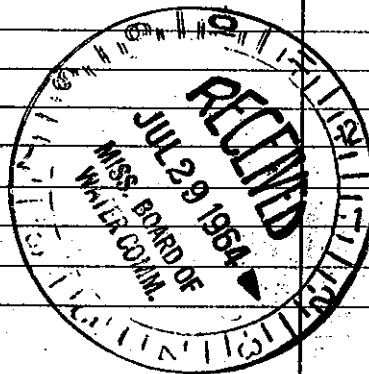

Well 1