

MISSISSIPPI BOARD OF WATER COMMISSIONERS

L.A.U.D.

G11

5-24-64

WATER WELL DRILLERS LOG

Date: 5-24, 1964, Driller: Bob Wilkinson County: Lauderdale  
(Name)

(1) Owner of Land:	Description & Color of Materials Sand, Clay, Red Clay, Shell, etc.	Thick- ness Feet	Depth Feet
<u>L. L. McAllister</u> (Name)	<u>white clay</u>	<u>20</u>	<u>1-20</u>
<u>Route #2 Meridian</u> (Address)	<u>gray sand</u>	<u>40</u>	<u>20-60</u>
(2) Location: <u>S.E. 1/4, N.E. 1/4, Sec. 29 T. 7 R. 15</u>	<u>Rock</u>	<u>2</u>	<u>46-48</u>
<u>5</u> miles <u>N.W.</u> of <u>Meridian</u> (distance) (direction) (Nearest Town)	<u>Blue clay</u>	<u>165</u>	<u>61-225</u>
(3) Topography: <u>hilly</u> (Hilly) (Flat) (Level)	<u>white sand</u>	<u>10</u>	<u>225-235</u>
(4) Purpose of Well: <u>Domestic</u> (Domestic Irrigation Municipal, Industrial, Other)	<u>Blue Clay</u>	<u>100</u>	<u>235-335</u>
	<u>Rock</u>	<u>0</u>	<u>335</u>


Information upon completion of well:

- (1) Diameter 2 inches.
- (2) Total Depth 335 feet.
- (3) Water Level 9 feet below top of ground.
- (4) Cased to 70, Size 2 in.
- (5) Screen: Size 0, Length \_\_\_\_\_.
- (6) Were any formations sealed against pollution?  
✓ yes, \_\_\_\_\_ no.

If YES depth of formation 20 to 60 ft.

Why surface water

Drillers Remarks: \_\_\_\_\_

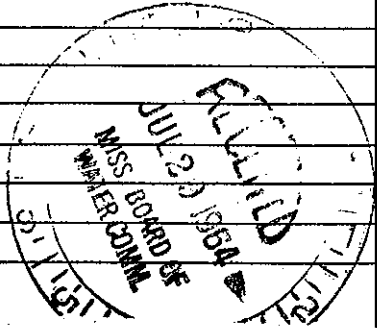

Well