

LANDERDALE  
 F 12  
 11-67

MISSISSIPPI  
 BOARD OF WATER COMMISSIONERS  
 416 North State Street  
 Jackson, Mississippi 39201

WATER WELL DRILLERS LOG

11-10-1967 Jerry Drilling Land  
 date well completed firm name county well located


LANDOWNER:  
 Hubert Rutherford  
 Rt 1 Collinsville, Miss  
 (mailing address)

| description of formations encountered | from | to  |
|---------------------------------------|------|-----|
| Yellow Clay                           | 0    | 15  |
| Sandy shale                           | 15   | 45  |
| shale                                 | 45   | 105 |
| hard streaks                          | 105  | 140 |
| hard shale                            | 140  | 220 |
| Sandy                                 | 220  | 280 |

WELL LOCATION:  
 sec. 18 T 7 N R 15 E  
 S W  
 8 miles NW of MHN  
 (distance) (direction) (nearest town)

WELL PURPOSE: Home  
 (home, irrigation, municipal, industrial)

- WELL COMPLETION DATA:
- (1) diameter (inches) 4"
  - (2) total depth (feet) 285
  - (3) static water level (feet) 35 (below above top of ground)
  - (4) casing (material) Blk (depth) 150  
 (size) If telescope see back.
  - (5) screen (length) No (depth to top)
  - (6) pump 1/2 (HP) 800M (material) (yield gpm)  
 Submerg (type power)
  - (7) electric log No (yes or no)  
 (organization running log)
  - (8) how well bottom plugged Open  
 bottom

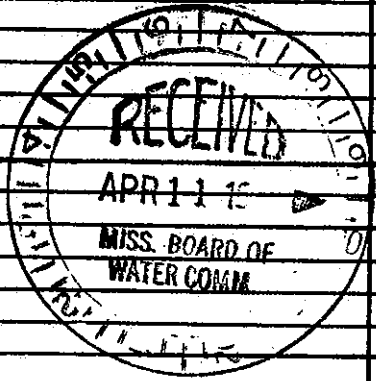

DRILLERS REMARKS: