

MISSISSIPPI BOARD OF WATER COMMISSIONERS

LAUD.

G 12

6-19-64

WATER WELL DRILLERS LOG

Date: 6-19, 19 64, Driller: Bob Williams County Lauderdale
(Name)

(1) Owner of Land:	Description & Color of Materials Sand, Clay, Red Clay, Shell, etc.	Thick- ness Feet	Depth Feet
<u>C. B. McWilliams</u> (Name)	<u>White Clay</u>	<u>15</u>	<u>1-15</u>
<u>Rt. 2 Meridian</u> (Address)	<u>White sand</u>	<u>10</u>	<u>15-25</u>
(2) Location: <u>NW 1/4, SE 1/4, Sec. 16 T. 7 R. 15</u>	<u>Blue Clay</u>	<u>100</u>	<u>25-125</u>
<u>10 miles NW</u> of <u>Meridian</u> (distance) (direction) (Nearest Town)	<u>Gray sand</u>	<u>24</u>	<u>125-149</u>
(3) Topography: <u>flat</u> (Hilly) (Flat) (Level)			
(4) Purpose of Well: <u>Domestic</u> (Domestic Irrigation Municipal, Industrial, Other)			


Information upon completion of well:

- (1) Diameter 4 inches.
- (2) Total Depth 149 feet.
- (3) Water Level 18 feet below top of ground.
- (4) Cased to 42, Size 4"
- (5) Screen: Size 0, Length _____
- (6) Were any formations sealed against pollution?
 yes, _____ no.

If YES depth of formation _____

Why surface water

Drillers Remarks: _____

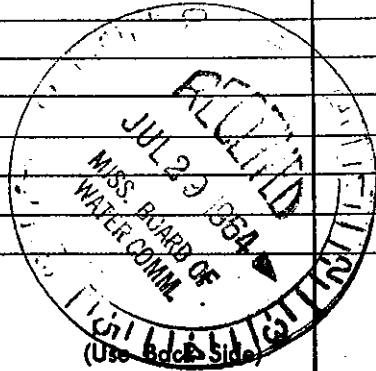

Well No. _____

Retain this copy for your office files.