

LAUD.

G 13

WATER WELL DRILLERS LOG

Date: 12-26-64, 1964, Driller: M. E. Donald & Hill, Inc, County: Lauderdale
(Name)


(1) Owner of Land:	Description & Color of Materials Sand, Clay, Red Clay, Shell, etc.	Thick- ness Feet	Depth Feet
<u>GEORGE E THORNTON</u> (Name)	<u>CLAY ST SAND</u>	<u>0</u>	<u>40</u>
<u>Rt #1, Bailey, Miss</u> (Address)	<u>SHALE</u>	<u>40</u>	<u>60</u>
<u>7 N 15 E</u>	<u>SAND ST SHALE</u>	<u>60</u>	<u>100</u>
(2) Location: <u>1/4</u> , <u>1/4</u> , Sec. <u>T</u> , <u>R</u>	<u>SHALE</u>	<u>100</u>	<u>120</u>
<u>1</u> miles <u>North</u> , of <u>Bailey</u> (distance) (direction) (Nearest Town)	<u>SAND</u>	<u>120</u>	<u>130</u>
(3) Topography: <input checked="" type="checkbox"/> (Hilly) <input type="checkbox"/> (Flat) <input type="checkbox"/> (Level)	<u>SHALE</u>	<u>130</u>	<u>245</u>
(4) Purpose of Well: <u>Domestic</u> (Domestic Irrigation, Municipal, Industrial, Other)	<u>SAND</u>	<u>245</u>	<u>265</u>
	<u>SHALE</u>	<u>265</u>	<u>340</u>
	<u>SAND</u>	<u>340</u>	<u>360</u>

Information upon completion of well:

- (1) Diameter 4 inches.
- (2) Total Depth 360' feet.
- (3) Water Level 190' feet below top of ground.
- (4) Cased to 228', Size 4"
- (5) Screen: Size None, Length —
- (6) Were any formations sealed against pollution?
— yes, no.

If YES depth of formation _____
Why _____

Drillers Remarks: _____

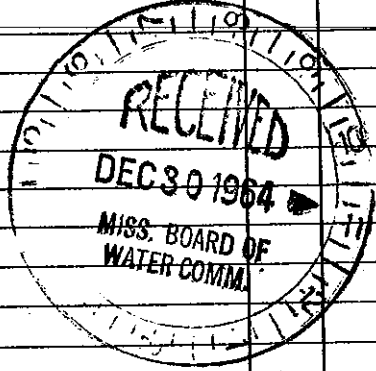

(Use Back Side)

Well No.

Mail this copy to Board of Water Commissioners 429 Miss. St. Jackson, Miss.