

G 15
4-29-65

WATER WELL DRILLERS LOG

Date: 6-29, 1965, Driller: McDonald & Hill, Inc. County Com. Lead 6
(Name)

(1) Owner of Land: Nelson Wilson
(Name)
Rt #1 Briley
(Address)

(2) Location: 1/4, 1/4, Sec. 2 1 15E
1 miles N of Briley
(distance) (direction) (Nearest Town)

(3) Topography: (Hilly) (Flat) (Level)

(4) Purpose of Well: Domestic
(Domestic Irrigation, Municipal, Industrial, Other)

Description & Color of Materials Sand, Clay, Red Clay, Shell, etc.	Thick- ness Feet	Depth Feet
<u>Clay</u>	<u>0</u>	<u>20</u>
<u>Shale</u>	<u>20</u>	<u>60</u>
<u>Shale lig. str.</u>	<u>60</u>	<u>120</u>
<u>Soft Shale</u>	<u>120</u>	<u>155</u>
<u>Sandy shale</u>	<u>155</u>	<u>180</u>
<u>lig. lat. shale</u>	<u>180</u>	<u>190</u>
<u>fine sand</u>	<u>190</u>	<u>230</u>

Information upon completion of well:

(1) Diameter 4 inches.

(2) Total Depth 230 feet.

(3) Water Level 120 feet below top of ground.

(4) Cased to 150, Size 4"


(5) Screen: Size 4, Length _____

(6) Were any formations sealed against pollution?
 yes, no.

If YES depth of formation _____

Why _____

Drillers Remarks: _____

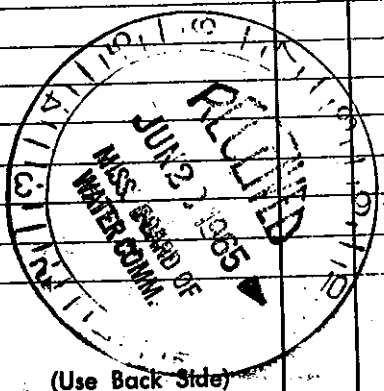

(Use Back Side)

Well No.