

100.
19
7-8-60

MISSISSIPPI BOARD OF WATER COMMISSIONERS

Lauderdale
Co.

WATER WELL DRILLERS LOG

Date: 7-8, 1960, Driller: Walter Ogletree, County: Lauderdale
(Name)

	Description & Color of Materials Sand, Clay, Red Clay, Shell, etc.	Thick- ness Feet	Depth Feet
(1) Owner of Land: J. F. Harst (Name) Rt 5 Meridian Miss (Address) 5 7 N 15 E	Blue clay		
(2) Location: 1/4, 1/4, Sec. T. R. 3 miles North of Meridian (distance) (direction) (Nearest Town)			
(3) Topography: Flat (Hilly) (Flat) (Level)			
(4) Purpose of Well: Home use (Domestic Irrigation Municipal, Industrial, Other)			


Information upon completion of well:

- (1) Diameter: 4 1/2 inches.
- (2) Total Depth: 339 feet.
- (3) Water Level: 35 feet below top of ground.
- (4) Cased to: 147, Size: 2"
- (5) Screen: Size _____, Length _____.
- (6) Were any formations sealed against pollution?
_____ yes, _____ no.

If YES depth of formation _____

Why _____

Drillers Remarks: _____

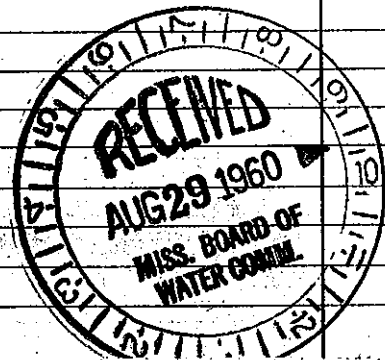

Well