

LAUO. MISSISSIPPI BOARD OF WATER COMMISSIONERS

G 21

5-21-65

WATER WELL DRILLERS LOG

Date: 5-21, 1965, Driller: McDonald & Hill, Inc. County Lauderdale

(Name)

(1) Owner of Land: West Mt. Airah part
 (Name) Rt # 2 Meridian
 (Address) 19 7N 15E

(2) Location: 1/4, 1/4, Sec. T R
5 miles West of Meridian
 (distance) (direction) (Nearest Town)

(3) Topography: (Hilly) (Flat) (Level)

(4) Purpose of Well: Domestic
 (Domestic Irrigation, Municipal, Industrial, Other)

Description & Color of Materials Sand, Clay, Red Clay, Shell, etc.	Thick- ness Feet	Depth Feet
Clay & sand shale	0	32
shale	32	40
Yellow sand fine	40	46
Br. shale light	46	65
H. blue shale	65	78
br. shale light	78	98
br. blue shale	98	103
Sandy shale	103	107
H. shale	107	124
Sandy shale	124	172

Information upon completion of well:

(1) Diameter 2 inches.

(2) Total Depth 172 feet.

(3) Water Level 81 feet below top of ground.

(4) Cased to 108, Size 2"


(5) Screen: Size _____, Length _____

(6) Were any formations sealed against pollution?
 yes, no.

If YES depth of formation _____

Why _____

Drillers Remarks: _____

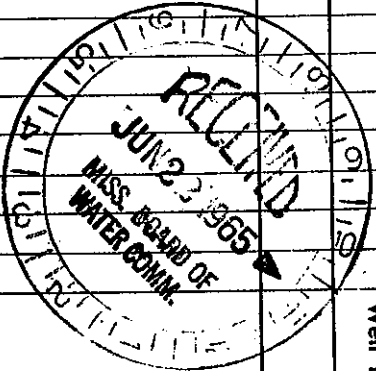

Well No.

(Use Back Side)

Mail this copy to Board of Water Commissioners 429 Miss. St. Jackson, Mis: