

LAUD. MISSISSIPPI

G22
2-24-64

WATER WELL DRILLING

Date: 2-24, 1964, Driller: Jerry County Laud

(1) Owner of Land: Wade Cross
(Name)

Bounds Rd, Meridian
(Address)

(2) Location: 1/4, 1/4, Sec. 22^{7N 15E} T. R.
2 miles NW of MDN
(distance) (direction) (Nearest Town)

(3) Topography: (Level)

(4) Purpose of Well: Domestic
(Domestic Irrigation, Municipal, Industrial, Other)

Description & Color of Materials Sand, Clay, Red Clay, Shell, etc.	Thick- ness Feet	Depth Feet
Yellow Clay sand	0	55
Blue Clay	35	240
Sandy silt	240	300
Sandy	300	365

Information upon completion of well:

(1) Diameter 3 inches.

(2) Total Depth 365 feet.

(3) Water Level 85 feet below top of ground.

(4) Cased to 189', Size 3"


(5) Screen: Size No, Length

(6) Were any formations sealed against pollution?
yes, no.

If YES depth of formation

Why

Drillers Remarks:

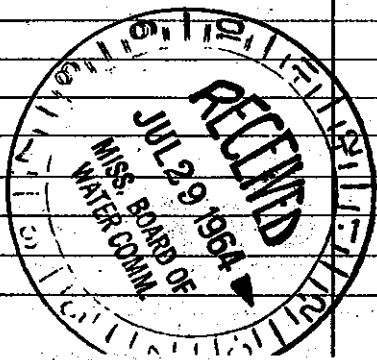

Well