

LAUDERDALE MISSISSIPPI BOARD

G 23

5-25-65

WATER WELL DRILLERS LOG

Date: 5-25, 1965, Driller: M. E. Donald & Hill County, Landowner

(Name)


(1) Owner of Land: GALILEE BAB, CHARLES
(Name)
127 2 MAIN
(Address)
(2) Location: 1/4, 1/4, Sec. 26 7N 4E
On King Road -
1 miles North, of Madison
(distance) (direction) (Nearest Town)
(3) Topography: HILLY
(Hilly) (Flat) (Level)
(4) Purpose of Well: DOMESTIC
(Domestic Irrigation
Municipal, Industrial, Other)

Description & Color of Materials Sand, Clay, Red Clay, Shell, etc.	Thick- ness Feet	Depth Feet
Clay	0	15
SHALE	15	25
SANDY CLAY	25	50
H SHALE	50	90
SOFT TO SANDY SHALE	90	133
M TO H SHALE	133	166
2' S SANDY SHALE	166	206
H SHALE	206	240
SOFT SHALE	240	254
SANDY SHALE FINE SAND	254	292

Information upon completion of well:

(1) Diameter 4 inches.
(2) Total Depth 292 feet.
(3) Water Level 147 feet below top of ground.
(4) Cased to 210, Size 4
(5) Screen: Size _____, Length _____
(6) Were any formations sealed against pollution?
_____ yes, _____ no.

If YES depth of formation _____
Why _____
Drillers Remarks: _____

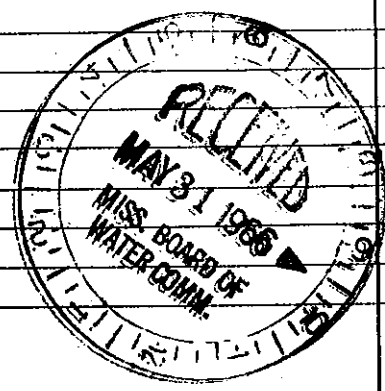

(Use Back Side)

Well No.

Mail this copy to Board of Water Commissioners 429 Miss. St. Jackson, Miss