

LAUD. MISSISSIPPI BOARD OF WATER COMMISSIONERS

G 29
10-7-63

WATER WELL DRILLERS LOG

Date: 10.7, 1963, Driller: M. E. Dunn & H. W. Inc., County Lauderdale

(Name)


(1) Owner of Land: Donald Cooksey
(Name)
R#5 Meridian
(Address)

(2) Location: 1/4, 1/4, Sec. 9 N 15E
(distance) (direction), of Meridian
(Nearest Town)

(3) Topography: X
(Hilly) (Flat) (Level)

(4) Purpose of Well: Domestic
(Domestic Irrigation Municipal, Industrial, Other)

Description & Color of Materials Sand, Clay, Red Clay, Shell, etc.	Thick- ness Feet	Depth Feet
CLAY	0	20
SAND	20	80
SHALE	80	270
FINE SAND	270	300
SANDY SHALE	300	350

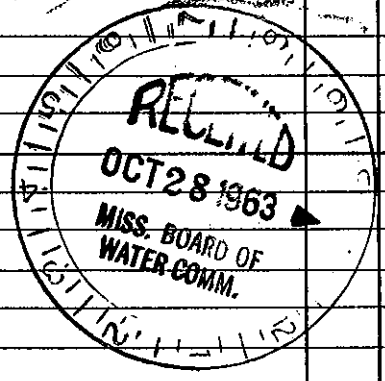

Information upon completion of well:

(1) Diameter 4" inches.

(2) Total Depth 350' feet.

(3) Water Level 15' feet below top of ground.

(4) Cased to 155', Size 4"

(5) Screen: Size _____, Length _____

(6) Were any formations sealed against pollution?
 _____ yes, _____ no.

If YES depth of formation _____

Why _____

Drillers Remarks: _____

Well