

LAUD.  
G 31

MISSISSIPPI BOARD OF WATER COMMISSIONERS

8-31-64

WATER WELL DRILLERS LOG


Date: 8-31, 1964, Driller: TERRY County LAUD  
(Name)

	Description & Color of Materials Sand, Clay, Red Clay, Shell, etc.	Thick- ness Feet	Depth Feet
(1) Owner of Land: <u>Billy JAMES</u> (Name) <u>RT 2, MERIDIAN, MISS</u> (Address)	<u>yellow sand &amp; clay</u>	<u>45'</u>	<u>45'</u>
(2) Location: <u>1/4, 1/4, Sec. 32 T 15 E R 2</u>	<u>sand &amp; shale</u>	<u>40'</u>	<u>85'</u>
<u>3</u> miles <u>NW</u> , of <u>MON.</u> (distance) (direction) (Nearest Town)	<u>blue dirt</u>	<u>50'</u>	<u>130'</u>
(3) Topography: <input checked="" type="checkbox"/> (Hilly) <input type="checkbox"/> (Flat) <input type="checkbox"/> (Level)	<u>sand</u>	<u>50'</u>	<u>180'</u>
(4) Purpose of Well: <u>DOMESTIC</u> (Domestic Irrigation Municipal, Industrial, Other)	<u>blue dirt</u>	<u>100'</u>	<u>280'</u>
	<u>sandy shale</u>	<u>105'</u>	<u>385'</u>

Information upon completion of well:

- (1) Diameter 3 inches.
- (2) Total Depth 385 feet.
- (3) Water Level 82' feet below top of ground.
- (4) Cased to 191, Size 3"
- (5) Screen: Size NO, Length \_\_\_\_\_.
- (6) Were any formations sealed against pollution?  
yes,  no.

If YES depth of formation \_\_\_\_\_  
Why \_\_\_\_\_  
Drillers Remarks: \_\_\_\_\_

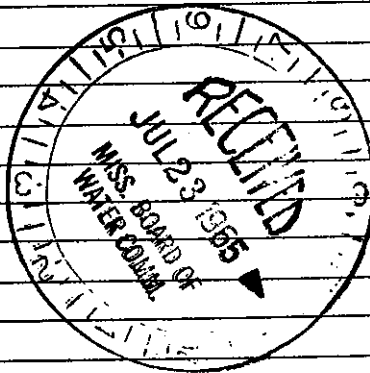

Well