

LAUD. MISSISSIPPI BOARD OF WATER COMMISSIONERS

G 33

7-30-65

WATER WELL DRILLERS LOG

Date: 7/30, 1965, Driller: Jerry Drilling
OVERSTREET County LAUD
(Name)

		Description & Color of Materials Sand, Clay, Red Clay, Shell, etc.	Thick- ness Feet	Depth Feet
(1) Owner of Land: <u>JOHN WAYNE HEDGETH</u> (Name)				
<u>BAILEY</u> (Address)	<u>Miss.</u>			
(2) Location: <u>33</u> <u>7N15C</u> <u>T R</u>		<u>Yellow clay + sand</u>	<u>0</u>	<u>165</u>
<u>8</u> miles <u>North</u> of <u>MdN.</u> (distance) (direction) (Nearest Town)		<u>SANDY SHALE</u>	<u>165</u>	<u>195</u>
(3) Topography: <input checked="" type="checkbox"/> (Hilly) <input type="checkbox"/> (Flat) <input type="checkbox"/> (Level)		<u>SHALE</u>	<u>195</u>	<u>295</u>
(4) Purpose of Well: <u>Domestic</u> (Domestic Irrigation Municipal, Industrial, Other)		<u>HARD SHALE + ROCK</u>	<u>295</u>	<u>360</u>
		<u>SAND</u>	<u>360</u>	<u>420</u>


Information upon completion of well:

- (1) Diameter 4 inches.
- (2) Total Depth 420 feet.
- (3) Water Level 165' feet below top of ground.
- (4) Cased to 234, Size 4
- (5) Screen: Size No, Length _____
- (6) Were any formations sealed against pollution?
_____ yes, _____ no.

If YES depth of formation _____

Why _____

Drillers Remarks: VERY Good
WATER

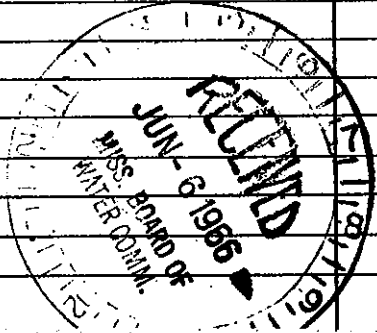

Well